

SIMPSON  
M17  
7-6-82

MISSISSIPPI  
BOARD OF WATER COMMISSIONERS  
416 North State Street  
Jackson, Mississippi 39201

CODED ✓

WATER WELL DRILLERS LOG ✓

7-6-1982 Gump well see SIMPSON  
date well completed firm name county well located

LANDOWNER:	description of formations encountered	from	to
Joh nny DRUMMOND	SAND	0	40
(mailing address)	CLAY	40	120
WELL LOCATION:	SAND	120	147
sec. 3 T 10 N R 21 E S W	CLAY	147	162
(distance) miles (direction) of (nearest town)	SAND	162	174
WELL PURPOSE:	CLAY	174	190
(home, irrigation, municipal, industrial)	SAND	190	210
WELL COMPLETION DATA:			
(1) diameter (inches) 2"			
(2) total depth (feet) 210			
(3) static water level (feet) 0 below top of ground.			
(4) casing PVC 190 (material) (depth)			
2" (size) if telescope see back.			
(5) screen 20 190 (length) (depth to top)			
2" PVC (size) (material)			
(6) pump 1 3 (HP) (yield gpm)			
(type power)			
(7) electric log (yes or no)			
(organization running log)			
(8) how well bottom plugged Buv			
DRILLERS REMARKS:			

CODED


DEPT. OF NATURAL RESOURCES  
BUREAU OF LAND & WATER RESOURCES

NOV 30 1982

RECEIVED

If well telescopes please sketch and show depths.

GROUND LEVEL

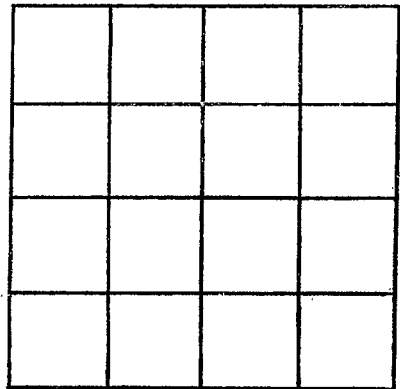

SECTION \_\_\_\_\_

Please indicate well location X.

ADDITIONAL INFORMATION

If more than one screen,  
show locations of each on sketch.