

Simpson
M 18 Elog 309
9-12-84

MISSISSIPPI
BOARD OF WATER COMMISSIONERS
416 North State Street
Jackson, Mississippi 39201

CODED


WATER WELL DRILLERS LOG

9-12 1984 Guinn Well Co Simpson
date well completed firm name county well located

LANDOWNER:	description of formations encountered	from	to
Johnny Ashley	Sand & gravel	0	100
(mailing address)	CLAY	100	330
WELL LOCATION: sec. 4 T. 10 N. R. 21 E W S	SAND	330	350
(distance) miles _____ of _____ (direction) (nearest town)	CODED		
WELL PURPOSE: (home, irrigation, municipal, industrial)			
WELL COMPLETION DATA:			
(1) diameter (inches) 9"			
(2) total depth (feet) 350			
(3) static water level (feet) 30 below top of ground.	361 on E log		
(4) casing PVC 330 (material) (depth) 9" (size) if telescope see back.			
(5) screen 20' 330 (length) (depth to top) 9" PVC (size) (material)			
(6) pump 1 6 (HP) (yield gpm)			
(type power)			
(7) electric log MGS (yes or no)			
(organization running log)	Boo		
(8) how well bottom plugged	Real PVC 1-7-85		
DRILLERS REMARKS:			

If well telescopes please sketch and show depths.

GROUND LEVEL

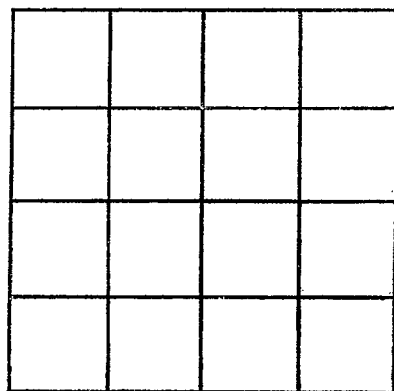

SECTION _____

Please indicate well location X.

ADDITIONAL INFORMATION

If more than one screen,
show locations of each on sketch.