

Simpson
 M 2000
 10-3-75

MISSISSIPPI
 BOARD OF WATER COMMISSIONERS
 416 North State Street
 Jackson, Mississippi 39201

WATER WELL DRILLERS LOG

10-3
 date well completed

1975 SPINER - GINN
 firm name

SIMPSON
 county well located

LANDOWNER:
 Troy Lee Catching
 (mailing address)

description of formations encountered	from	to
Top Soil	0	1
Clay	1	45
clay + chnk.	45	79
Chalk	79	106
SAND	106	145

WELL LOCATION:
 sec. 15 T 9 N R 21 E
 S W
 10 miles W of Shreveport
 (distance) (direction) (nearest town)

WELL PURPOSE: Home
 (home, irrigation, municipal, industrial)


- WELL COMPLETION DATA:
- (1) diameter (inches) 5"
 - (2) total depth (feet) 145'
 - (3) static water level (feet) 25' below top of ground.
 - (4) casing PVC 135'
 (material) (depth)
 (size) if telescope see back.
 - (5) screen 10' 135'
 (length) (depth to top)
 2" PVC
 (size) (material)
 - (6) pump 1 HP 7 (yield gpm)
 Elec
 (type power)
 - (7) electric log NO
 (yes or no)
 (organization running log)
 - (8) how well bottom plugged
 No valve

DRILLERS REMARKS:

DEC 22 1975

If well telescopes please sketch and show depths.

GROUND LEVEL

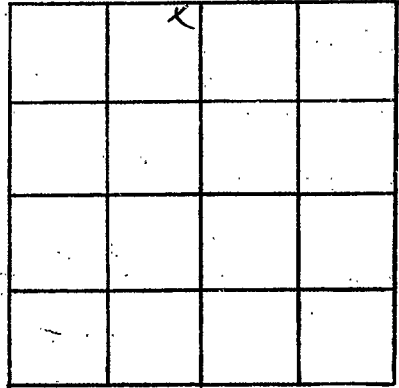

SECTION 14

Please indicate well location X.

ADDITIONAL INFORMATION

If more than one screen, show locations of each on sketch.