

Simpson
M 2001
11-4-75

MISSISSIPPI
 BOARD OF WATER COMMISSIONERS
 416 North State Street
 Jackson, Mississippi 39201

WATER WELL DRILLERS LOG

11-4
 date well completed

13T

1975 ORDER - COIN
 firm name

SIMPSON
 county well located

LANDOWNER: CARROL BERRY

description of formations encountered

from to

St. 1

Top Soil

0 1

Pinola, Ms.

Clay

1 14

(mailing address)

Gravel

14 17

WELL LOCATION:

Chalk

17 50

sec. 25 T. 10 N. R. 21 E.

Sand

50 140

4 miles E of Abbeville
 (distance) (direction) (nearest town)

Shell

140 160

Sand

160 200

WELL PURPOSE: Water
 (home, irrigation, municipal, industrial)

WELL COMPLETION DATA:

(1) diameter (inches) 2"

(2) total depth (feet) 210

(3) static water level (feet) 50 below above top of ground.

(4) casing PVC, 200,
 (material) (depth)

2" if telescope see back.
 (size)

(5) screen 10, 200
 (length) (depth to top)

2", PVC
 (size) (material)


(6) pump No Permp
 (HP) (yield gpm)

(type power)

(7) electric log NO
 (yes or no)

(organization running log)

(8) how well bottom plugged B W VALVE

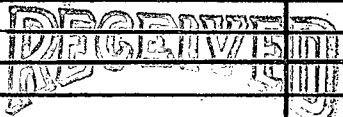


MAR 29 1976

DRILLERS REMARKS:

If well telescopes please
sketch and show depths.

GROUND LEVEL

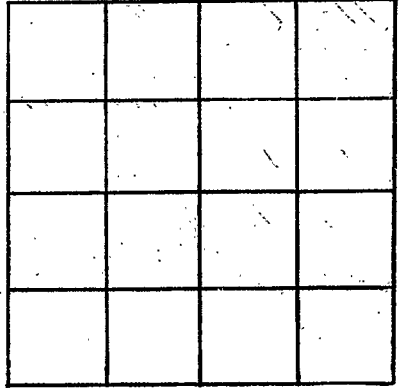

SECTION _____

Please indicate well location X.

ADDITIONAL INFORMATION

If more than one screen,
show locations of each on sketch.