

Simpson
M 2002
E-21-77

C. P. CLARK
MISSISSIPPI WATER WELL DRILLING
BOARD OF WATER COMMISSIONERS
416 North State Street ROUTE 2
137 Jackson, Mississippi 39201 LAUREL, MISS. 39440

WATER WELL DRILLERS LOG

2/21 1977 C.P. Clark Simpson
date well completed firm name county well located

LANDOWNER: Mary Jane Bridges
Pionola Miss.
Rt #1
(mailing address)

description of formations encountered	from	to
Sandy Clay	0	5
Sand & Gravel	5	16
Gravel (medium)	16	44
White Clay	44	55
Sand	55	64

WELL LOCATION:
sec. 1 T. 10(N) R. 2(E)
S W
5 miles W of Pionola
(distance) (direction) (nearest town)

WELL PURPOSE: Home
(home, irrigation, municipal, industrial)

- WELL COMPLETION DATA:
- (1) diameter (inches) 2
 - (2) total depth (feet) 64
 - (3) static water level (feet) 18 below top of ground.
 - (4) casing Galvalume 59 (material) (depth)
 - (5) screen 5 59 (length) (depth to top)
 - 1 1/4 S.S. 006 (size) (material)
 - (6) pump 1 15 (HP) (yield gpm)
 - Electric (type power)
 - (7) electric log no (yes or no)
 - (organization running log)
 - (8) how well bottom plugged BwU


RECEIVED
APR 1 1977

DRILLERS REMARKS: Set 12 A
Get @ 42 ft

MISS. BD. OF WATER COMMISSIONERS

If well telescopes please sketch and show depths.

GROUND LEVEL

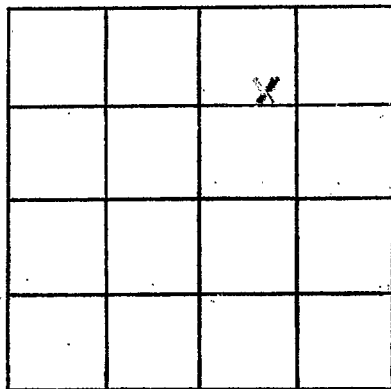

SECTION 1

Please indicate well location X.

ADDITIONAL INFORMATION

If more than one screen,
show locations of each on sketch.