

SIMPSON
M
2003
2-27-78

**MISSISSIPPI  
BOARD OF WATER COMMISSIONERS**  
416 North State Street  
Jackson, Mississippi 39201

**WATER WELL DRILLERS LOG**

7/27 1978 Tom Guffit Flushing Simpson  
 date well completed firm name county well located

**LANDOWNER:**  
Mississippi Land Co -  
Suite 241 Highland Village  
Jackson Miss (mailing address)

description of formations encountered	from	to
<u>top soil</u>	<u>0</u>	<u>2</u>
<u>clay</u>	<u>2</u>	<u>25</u>
<u>clay</u>	<u>25</u>	<u>75</u>
<u>sand</u>	<u>75</u>	<u>100</u>

**WELL LOCATION:**  
 sec. 15 T. 10(N) R. 21E  
7 miles W of Shively  
 (distance) (direction) (nearest town)

**WELL PURPOSE:** Home  
 (home, irrigation, municipal, industrial)

- WELL COMPLETION DATA:**
- diameter (inches) 2"
  - total depth (feet) 100 ft.
  - static water level (feet) 130 - below above top of ground.
  - casing Plastic 90 ft.  
 (material) (depth)  
2" if telescope see back.  
 (size)
  - screen 10 ft. 90 ft.  
 (length) (depth to top)  
Plastic  
 (size) (material)
  - pump No pump  
 (HP) (yield gpm)  
Electric  
 (type power)
  - electric log no  
 (yes or no)  
n/a  
 (organization running log)
  - how well bottom plugged n/a  
B.W. Valve


**DRILLERS REMARKS:**

**RECEIVED**  
 APR 27 1978

MISS. BD OF WATER COMM

If well telescopes please sketch and show depths.

GROUND LEVEL

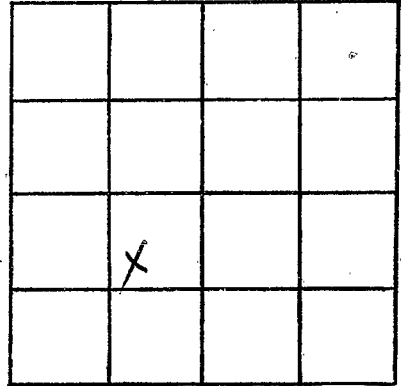

SECTION 15

Please indicate well location X.

ADDITIONAL INFORMATION

If more than one screen,  
show locations of each on sketch.