

SIMPSON

M 2004

MISSISSIPPI
 BOARD OF WATER COMMISSIONERS
 416 North State Street
 Jackson, Mississippi 39201

WATER WELL DRILLERS LOG

TOM GRIFFITH

PLUMBING & WELL SERVICE, INC.
 320 MAYSON AVE.

Seneca County
 County well located

April 25 1978
 date well completed

COLUMBIA, MS 39429

description of formations encountered

from to

LANDOWNER:
Henry Holfield
Liburich
 (mailing address)

description of formations encountered	from	to
<i>top soil</i>	<i>0</i>	<i>1</i>
<i>Chalk</i>	<i>1</i>	<i>25</i>
<i>gravel</i>	<i>25</i>	<i>35</i>
<i>Chalk</i>	<i>35</i>	<i>190</i>
<i>sand</i>	<i>190</i>	<i>225</i>

WELL LOCATION:

sec *25 T 10 S R 21 E*
4 miles *W* of *Deer*
 (distance) (direction) (nearest town)

WELL PURPOSE: *Home*
 (home, irrigation, municipal, industrial)

WELL COMPLETION DATA:

- (1) diameter (inches) *2"*
- (2) total depth (feet) *225*
- (3) static water level (feet) *110* below above top of ground.
- (4) casing *Plexin 205*
 (material) (depth)
 If telescope see back.
 (size)
- (5) screen *20 205*
 (length) (depth to top)
2 Plexin
 (size) (material)
- (6) pump *1 1/2 10*
 (HP) (yield gpm)
Elec.
 (type power)
- (7) electric log *NO*
 (yes or no)
A-A
 (organization running log)
- (8) how well bottom plugged *Sealed*


RECEIVED
 MAY 24 1978

DRILLERS REMARKS:

MISS. BD. OF WATER COMM

If well telescopes please sketch and show depths.

GROUND LEVEL

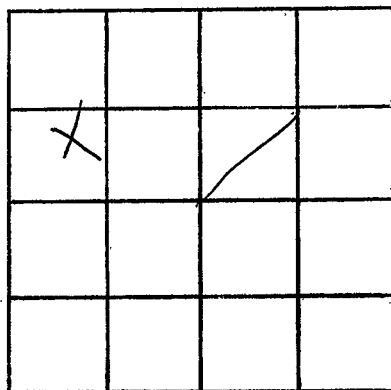

SECTION 25

Please indicate well location X.

ADDITIONAL INFORMATION

If more than one screen,
show locations of each on sketch.