

SIMPSON
 M 2005
 11-09-78

MISSISSIPPI
 BOARD OF WATER COMMISSIONERS
 416 North State Street
 Jackson, Mississippi 39201

WATER WELL DRILLERS LOG

11-9-78 date well completed
 19 Quinn WATER WELLS SIMPSON firm name
 county well located

LANDOWNER:
 SMITH
 (mailing address)
 WELL LOCATION:
 sec. 35 T-10 N R-21 W
 miles of
 (distance) (direction) (nearest town)

description of formations encountered	from	to
CLAY	0	305
SAND	305	340
CLAY	340	360
SAND	360	390

WELL PURPOSE:
 (home, irrigation, municipal, industrial)


WELL COMPLETION DATA:
 (1) diameter (inches) 2
 (2) total depth (feet) 385
 (3) static water level (feet) 0 below above top of ground.
 (4) casing PVC 365 (material) (depth)
 2 (size) If telescope see back.
 (5) screen 20 365 (length) (depth to top)
 2 PVC (size) (material)
 (6) pump 13 10 (HP) (yield gpm)
 (type power)
 (7) electric log Yes (yes or no)
 (organization running log)
 (8) how well bottom plugged Back

DRILLERS REMARKS:

RECEIVED
 DEC 13 1978

If well telescopes please sketch and show depths.

GROUND LEVEL

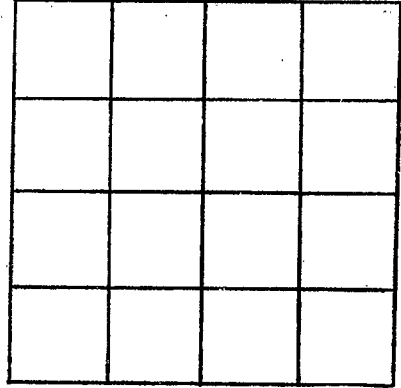

SECTION _____

Please indicate well location X.

ADDITIONAL INFORMATION

If more than one screen, show locations of each on sketch.