

SIMPSON  
M 2006  
7-23-80

MISSISSIPPI  
BOARD OF WATER COMMISSIONERS  
416 North State Street  
Jackson, Mississippi 39201

WATER WELL DRILLERS LOG

TOM GRIFFITH

PLUMBING & WELL SERVICE, INC.

320 MAYSON AVE.

COLUMBIA, MS 39429

July 23 1980  
date well completed

Simpson  
county well located

LANDOWNER:	description of formations encountered	from	to
Martha Magruder	Top Soil	0	4
Route 1643 miles (mailing address)	Clay	4	30
	Sand	30	90
	Clay	90	140
	Sand	140	200
WELL LOCATION:			
sec. T. 10 N R. 21 W			
4 miles East of Rootport (distance) (direction) (nearest town)			
WELL PURPOSE:			
(home, irrigation, municipal, industrial)			
WELL COMPLETION DATA:			
(1) diameter (inches) 2			
(2) total depth (feet) 200			
(3) static water level (feet) 76 below top of ground.			
(4) casing (material) steel (depth) 200			
2 (size) If telescope see back.			
(5) screen (length) 20 (depth to top) 180			
2 (size) (material) plastic			
(6) pump (HP) 1 (yield gpm) 10			
6k (type power)			
(7) electric log (yes or no)			
(organization running log)			
(8) how well bottom plugged B.W.V.			
DRILLERS REMARKS:			


DEPT. OF NATURAL RESOURCES  
BUREAU OF LAND & WATER RESOURCES

SEP 5 - 1980

RECEIVED

If well telescopes please sketch and show depths.

GROUND LEVEL

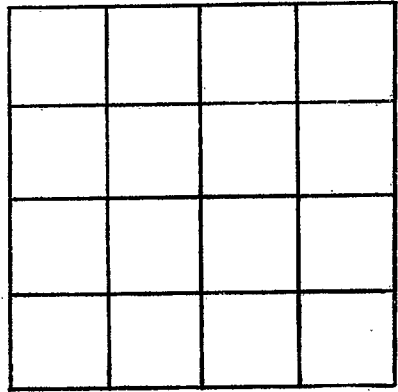

SECTION \_\_\_\_\_

Please indicate well location X.

ADDITIONAL INFORMATION

If more than one screen, show locations of each on sketch.