

MISSISSIPPI DEPARTMENT OF NATURAL RESOURCES

Bureau of Land and Water Resources

Southport Mall

P.O. Box 10631

Jackson, Mississippi 39209

WATER WELL DRILLERS LOG

Simpson
 M 2008

3-14-82 date well completed Griner Drilling Service, Inc. firm name Simpson county well located

LANDOWNER:
 Transcontinental Oil Corp.
 1700 Capital Towers
 Jackson, Ms. 39205
 (mailing address)

description of formations encountered	from	to
clay, gravel	0	10
sand, gravel streaked with clay	10	63
sand gravel	63	189

WELL LOCATION: 1000' N & 1200' E
 sec. 25 T. 10 N R. 19 E SW/4
 No. 1 James Oak Grove Field
 (distance) (direction) (nearest town)

WELL PURPOSE: oil field supply
 (home, irrigation, municipal, industrial)

- WELL COMPLETION DATA:
- (1) diameter (inches) 3"
 - (2) total depth (feet) 189'
 - (3) static water level (feet) 40' ^{below} top of ground.
 - (4) casing steel, 189'
 (material) (depth)
3" if telescope see back.
 (size)
 - (5) screen 42', 147'
 (length) (depth to top)
3", perforated
 (size) (material)
 - (6) pump 80
 (HP) (yield gpm)
AC
 (type power)
 - (7) electric log
 (yes or no)
 (organization running log)
 - (8) how well bottom plugged orange
peel

DEPT. OF NATURAL RESOURCES
 BUREAU OF LAND & WATER RESOURCES


MAR 18 1982

RECEIVED

DRILLERS REMARKS:

If well telescopes please sketch and show depths.

GROUND LEVEL

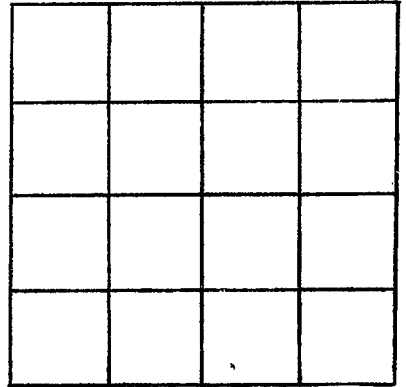

SECTION _____

Please indicate well location X.

ADDITIONAL INFORMATION

If more than one screen,
show locations of each on sketch.