

SIMPSON

N 1

12-67

MISSISSIPPI
 BOARD OF WATER COMMISSIONERS
 416 North State Street
 Jackson, Mississippi 39201

WATER WELL DRILLERS LOG

CODED

Dec. 4

date well completed

1967 W.G. Butler

firm name

SIMPSON

county well located

LANDOWNER: T.G. Lee

Shivers, Miss

(mailing address)

WELL LOCATION:

sec 34 T. 10N S R. 20 E W. 1 miles W of Shivers
 (distance) (direction) (nearest town)

WELL PURPOSE: home
 (home, irrigation, municipal, industrial)

WELL COMPLETION DATA:

- (1) diameter (inches) 2"
- (2) total depth (feet) 130'
- (3) static water level (feet) 120 ^{below}/_{above} top of ground.
- (4) casing galv. 125
 (material) (depth)
2" if telescope see back.
 (size)
- (5) screen 5' 125
 (length) (depth to top)
2" stainless steel
 (size) (material)
- (6) pump 1/2 Electric
 (HP) (yield gpm)
 (type power)
- (7) electric log No
 (yes or no)
 (organization running log)
- (8) how well bottom plugged 2" B.N.V.


description of formations encountered

from

to

| | | |
|-----------------|-----|-----|
| Red clay + Sand | 1 | 10 |
| Red Sand | 10 | 30 |
| Sand | 30 | 50 |
| Sand + Chalk | 50 | 140 |
| Sand | 110 | 140 |


CODED

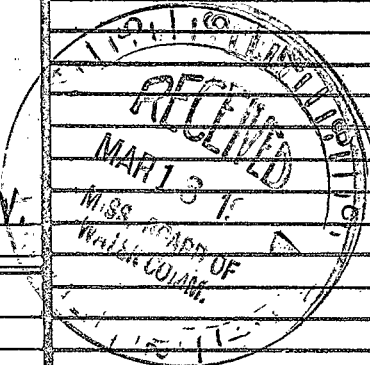

DRILLERS REMARKS:

If well telescopes please sketch and show depths.

GROUND LEVEL

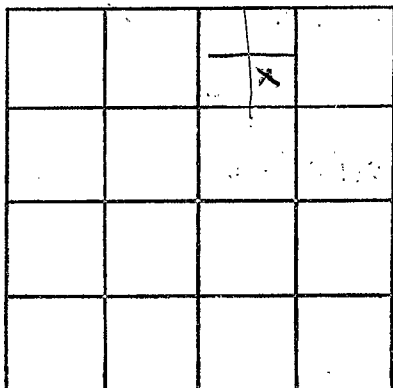

SECTION 34

Please indicate well location X.

ADDITIONAL INFORMATION

If more than one screen,
show locations of each on sketch.