

N 2
9-12-60

WATER WELL DRILLERS LOG

CODED 300

Date sep 12, 1960, Driller: James A. White County Simpson
(Name)

(1) Owner of Land Marshal Codey
(Name)
Piscola miss
(Address)

Description & Color of Materials Sand, Clay, Red Clay, Shell, etc.	Thick- ness Feet	Depth Feet
<u>Red clay first</u>	<u>20</u>	<u>20</u>
<u>Red sand</u>	<u>140</u>	<u>125</u>
<u>Water sand</u>	<u>20</u>	<u>145</u>

(2) Location: 1/4, 1/4, Sec. 20 T10R20
3 miles west of Shivers
(distance) (direction) (Nearest Town)

(3) Topography: (Hilly) (Flat) (Level)

(4) Purpose of Well: Domestic
(Domestic Irrigation
Municipal, Industrial, Other)

Information upon completion of well:

(1) Diameter 2 inches.

(2) Total Depth 145 feet.

(3) Water Level 130 feet below top of ground.

(4) Cased to Point, Size 2

(5) Screen: Size 6 ft 1 1/4', Length _____


(6) Were any formations sealed against pollution?

_____ yes, no.

If YES depth of formation _____

Why _____

Drillers Remarks: _____

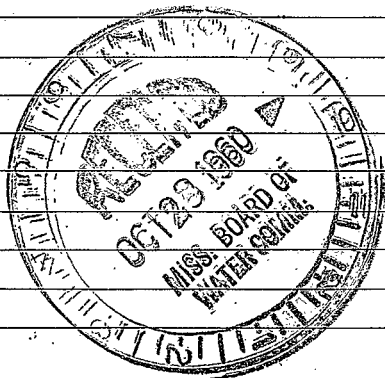

(Use Back Side)

Well No.

