

SIMPSON

N 3  
7-29-61

# WATER WELL DRILLERS LOG

N

Date: July 29, 1961, Driller: W.G. Butler County Simpson  
Smith  
(Name)

(1) Owner of Land: C.C. McNAIR.  
(Name)

Mendenhall, Miss. Pt.  
(Address)

(2) Location: SE 1/4, SW 1/4, Sec 29 T10R28  
3 miles West, of Shivers  
(distance) (direction) (Nearest Town)

(3) Topography:  (Hilly)  (Flat)  (Level)

(4) Purpose of Well: Domestic  
(Domestic Irrigation  
Municipal, Industrial, Other)

Descriptions & Color of Materials Sand, Clay, Red Clay, Shell, etc.	Thick- ness Feet	Depth Feet
Clay	1-5	
Red Sand	5-17	
Chalk	17-20	
Chalk + Sand	26-50	
Sand	51-55	
Chalk	55-60	
Sand	60-100	
Sand + Chalk	100-110	
Sand	110-115	
Sand + Chalk	115-120	
Sand	120-130	

### Information upon completion of well:

(1) Diameter 2 inches.

(2) Total Depth 128 feet.

(3) Water Level 113 feet below top of ground.

(4) Cased to 105', Size 3"


(5) Screen: Size 1 1/4", Length 5'

(6) Were any formations sealed against pollution?  
       yes,        no.

If YES depth of formation \_\_\_\_\_

Why \_\_\_\_\_

Drillers Remarks: 1

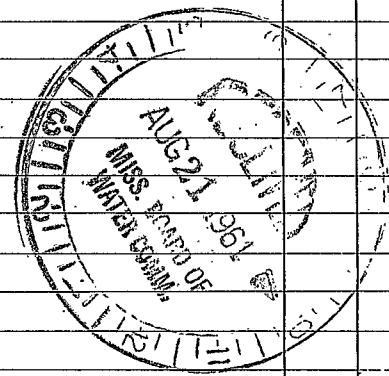

(Use Back Side)

Well No.

Retain this copy for your office files.

1870

Received of the Hon. Secy of the Navy  
the sum of \$1000.00 for the  
purchase of the schooner "Albatross"  
for the service of the U.S. Navy  
under the order of the Hon. Secy of the Navy  
dated the 10th day of June 1870

Wm. H. Hunt  
Comdr. U.S. Navy