

ELOG # 148

MISSISSIPPI
BOARD OF WATER COMMISSIONERS
416 North State Street
Jackson, Mississippi 39201

SIMPSON
N-4
8-9-71

WATER WELL DRILLERS LOG

CODED

Aug 9, 1971 19 R. E. Simpson Simpson
date well completed firm name county well located

LANDOWNER:
J. E. Sherman
Shivers
(mailing address)

description of formations encountered	from	to
<u>Top soil</u>	<u>0</u>	<u>5</u>
<u>White clay</u>	<u>5</u>	<u>130</u>
<u>Fine sand</u>	<u>130</u>	<u>174</u>
<u>White clay</u>	<u>174</u>	<u>194</u>
<u>Sand</u>	<u>194</u>	<u>214</u>

WELL LOCATION:
sec 30 T 10 N R 20 E
S W
4 miles W of Shivers
(distance) (direction) (nearest town)

WELL PURPOSE:
(home, irrigation, municipal, industrial)

- WELL COMPLETION DATA:
- (1) diameter (inches) 2"
 - (2) total depth (feet) 214
 - (3) static water level (feet) 98 below above top of ground.
 - (4) casing Plastic 204 (material) (depth)
2" (size) If telescope see back.
 - (5) screen 2" x 10" 204 (length) (depth to top)
#.006 Plastic (size) (material)
 - (6) pump 1 1/2 HP (HP) 6 (yield gpm)
Inst (type power)
 - (7) electric log Yes (yes or no)
Smith S. (organization running log)
 - (8) how well bottom plugged Plastic

CODED


AUG 13 1971

DRILLERS REMARKS:

MISS. BD. OF
WATER COMM.

If well telescopes please sketch and show depths.

GROUND LEVEL

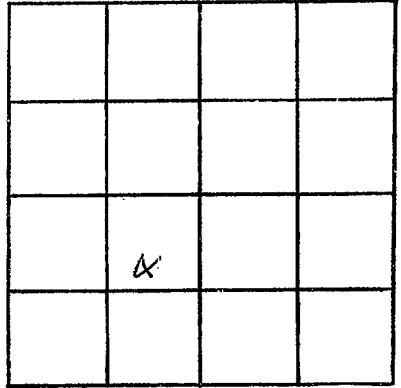

SECTION 30

Please indicate well location X.

ADDITIONAL INFORMATION

If more than one screen, show locations of each on sketch.