

SIMPSON
N8
12-20-73

MISSISSIPPI
 BOARD OF WATER COMMISSIONERS
 416 North State Street
 Jackson, Mississippi 39201

CODED

WATER WELL DRILLERS LOG


Simpson
Jeff Davis
 country well located

12-20 19 73
 date well completed

GRINER - GINN
 firm name

LANDOWNER:	description of formations encountered	from	to
Mr. Wayman Otis Rt. 2 Prentiss, Miss. (mailing address)			
	Clay	1	41
	Clay & chalb.	41	94
	Sand	94	123
WELL LOCATION:			
sec 22 T 10 S R 20 E 12 miles N/W of New Helton (distance) (direction) (nearest town)			
WELL PURPOSE: (home, irrigation, municipal, industrial)			
WELL COMPLETION DATA:			
(1) diameter (inches) 2"			
(2) total depth (feet) 123			
(3) static water level (feet) 95 below top of ground.			
(4) casing plastic, 113, (material) (depth) 2" (size) If telescope see back.			
(5) screen 10', 113 (length) (depth to top) 2" plastic (size) (material)			
(6) pump 1 (HP) 6 (yield gpm) elec. (type power)			
(7) electric log NO (yes or no) NO (organization running log)			
(8) how well bottom plugged B-W Valve			
DRILLERS REMARKS:			


CODED

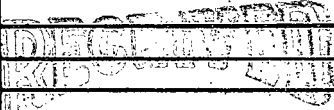

MAY 23 1974

If well telescopes please sketch and show depths.

GROUND LEVEL

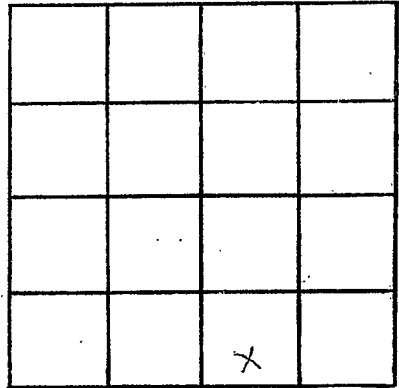

SECTION 22

Please indicate well location X.

ADDITIONAL INFORMATION

If more than one screen,
show locations of each on sketch.