

SIMPSON  
 N9  
 12-6-73

MISSISSIPPI  
 BOARD OF WATER COMMISSIONERS  
 416 North State Street  
 Jackson, Mississippi 39201

CODED

WATER WELL DRILLERS LOG

GRINER - GINN

SIMPSON  
 Jeff Daves  
 county well located

12-6-1973  
 date well completed

firm name

LANDOWNER:  
 Mr. Sallie Smith  
 Rt. 2, Box 55, New Hebron  
 (mailing address) Miss.


description of formations encountered	from	to
Top Soil	0	1
Clay	1	13
Sand & gravel	13	20
Chalk & Clay	20	173
Sand	173	163

WELL LOCATION:  
 sec. 4 T. 9 N. R. 20 E.  
 S. E.  
 10 miles N.W. of New Hebron  
 (distance) (direction) (nearest town)

WELL PURPOSE: Home  
 (home, irrigation, municipal, industrial)

- WELL COMPLETION DATA:
- (1) diameter (inches) 2"
  - (2) total depth (feet) 163
  - (3) static water level (feet) 105 below top of ground.
  - (4) casing plastic, 153, (material) (depth)  
 2" (size) if telescope see back.
  - (5) screen 10', 153 (length) (depth to top)  
 2" plastic (size) (material)
  - (6) pump 1 (HP) 6 (yield gpm)  
 elec (type power)
  - (7) electric log NO (yes or no)  
 NO (organization running log)
  - (8) how well bottom plugged B.W. Valve

CODED

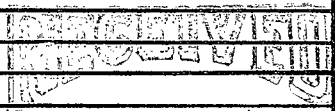


DRILLERS REMARKS:

MAY 22 1974

If well telescopes please sketch and show depths.

GROUND LEVEL

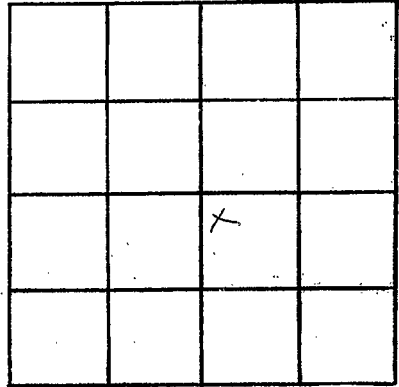

SECTION 4

Please indicate well location X.

ADDITIONAL INFORMATION

If more than one screen,  
show locations of each on sketch.