

SIMPSON
N 10
4-8-74

MISSISSIPPI
 BOARD OF WATER COMMISSIONERS
 416 North State Street
 Jackson, Mississippi 39201

CODED

WATER WELL DRILLERS LOG

GRINER - GINN

Simpson

John Daves

4-8 1974
 date well completed

firm name

county well located

LANDOWNER:

George Rowley
New Hebron
 (mailing address)

description of formations encountered

from to

<i>Top Soil</i>	<i>0</i>	<i>1</i>
<i>clay</i>	<i>1</i>	<i>33</i>
<i>clay + chalks</i>	<i>33</i>	<i>65</i>
<i>sand</i>	<i>65</i>	<i>95</i>

WELL LOCATION:

sec. *11* T. *9* N. R. *20* W.
5 miles *N* of *New Hebron*
 (distance) (direction) (nearest town)


WELL PURPOSE:

Home
 (home, irrigation, municipal, industrial)

CODED

WELL COMPLETION DATA:

- (1) diameter (inches) 2"
- (2) total depth (feet) 95
- (3) static water level (feet) 50 below above top of ground.
- (4) casing plastic 85
 (material) (depth)
2" if telescope see back.
 (size)
- (5) screen 10' 85
 (length) (depth to top)
2" plastic
 (size) (material)
- (6) pump 1 6
 (HP) (yield gpm)
elec
 (type power)
- (7) electric log NO
 (yes or no)
NO
 (organization running log)
- (8) how well bottom plugged
B.W. Valve

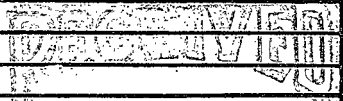


MAY 28 1974

DRILLERS REMARKS:

If well telescopes please sketch and show depths.

GROUND LEVEL

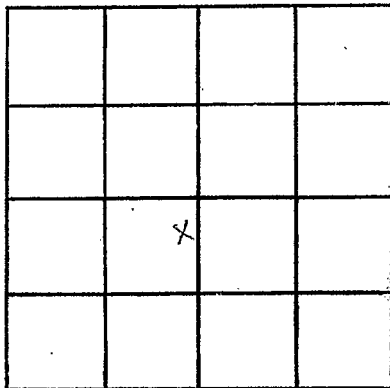

SECTION 11

Please indicate well location X.

ADDITIONAL INFORMATION

If more than one screen, show locations of each on sketch.