

SIMPSON  
 N 11  
 4-8-74

MISSISSIPPI  
 BOARD OF WATER COMMISSIONERS  
 416 North State Street  
 Jackson, Mississippi 39201

CODED

WATER WELL DRILLERS LOG

SIMPSON  
 J. H. David

4-8 1974 GRINER firm name date well completed  
 county well located

LANDOWNER:  
 Mr. B. A. Smith  
 P.O. Box 157, New Hebron  
 (mailing address) Miss

description of formations encountered	from	to
top soil	0	1
clay	1	40
sand	40	65

WELL LOCATION:  
 sec. 11 T. 9 N. R. 20 E.  
 5 miles N. of New Hebron  
 (distance) (direction) (nearest town)

WELL PURPOSE: Home  
 (home, irrigation, municipal, industrial)

- WELL COMPLETION DATA:
- (1) diameter (inches) 2"
  - (2) total depth (feet) 65
  - (3) static water level (feet) 30 below top of ground.
  - (4) casing plastic, 55, (material) (depth)  
 2" (size) if telescope see back.
  - (5) screen 10', 55 (length) (depth to top)  
 2" plastic (size) (material)
  - (6) pump 1 (HP) 6 (yield gpm)  
 elec. (type power)
  - (7) electric log NO (yes or no)  
 NO (organization running log)
  - (8) how well bottom plugged  
 B.W. Valve


CODED

MAY 23 1974

DRILLERS REMARKS:

If well telescopes please sketch and show depths.

GROUND LEVEL

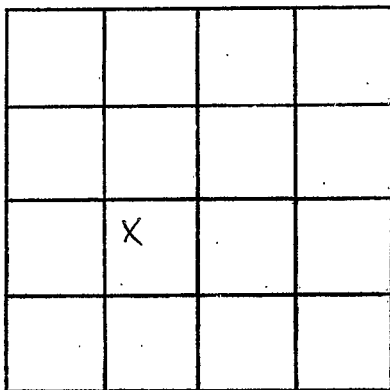

SECTION 11

Please indicate well location X.

ADDITIONAL INFORMATION

If more than one screen, show locations of each on sketch.