

SIMPSON
 N12
 4-8-74

MISSISSIPPI
 BOARD OF WATER COMMISSIONERS
 416 North State Street
 Jackson, Mississippi 39201

CODED

WATER WELL DRILLERS LOG

GRINER - GINN

Simpson
John Davis
 county well located

4-8 1974
 date well completed

firm name

LANDOWNER:	description of formations encountered	from	to
Mr. Jessie Smith	top soil	0	1
Rt. 2 New Hebron	Clay	1	47
(mailing address) Miss.	Clay & chalk	47	114
	Sand	114	153
WELL LOCATION:			
sec. 35 T. 10 N. R. 20 E.			
12 miles N. of New Hebron			
(distance) (direction) (nearest town)			
WELL PURPOSE: Home			
(home, irrigation, municipal, industrial)			
WELL COMPLETION DATA:			
(1) diameter (inches) 2"			
(2) total depth (feet) 163			
(3) static water level (feet) 110 below top of ground.			
(4) casing plastic 153 (material) (depth)			
2" (size) if telescope see back.			
(5) screen 10' 153 (length) (depth to top)			
2" plastic (size) (material)			
(6) pump 1 1/2 7 (HP) (yield gpm)			
elec. (type power)			
(7) electric log NO (yes or no)			
NO (organization running log)			
(8) how well bottom plugged B.W. Valve			
DRILLERS REMARKS:			


CODED

RECEIVED
 MAY 22 1974

MISS. Bd. OF WATER COMMISSIONERS

If well telescopes please sketch and show depths.

GROUND LEVEL

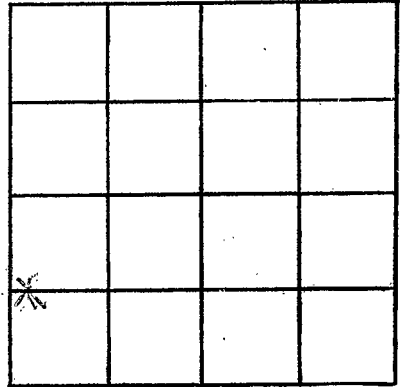

SECTION 35

Please indicate well location X.

ADDITIONAL INFORMATION

If more than one screen,
show locations of each on sketch.