

SIMPSON  
 N 13  
 3-22-74

MISSISSIPPI  
 BOARD OF WATER COMMISSIONERS  
 416 North State Street  
 Jackson, Mississippi 39201

CODED

WATER WELL DRILLERS LOG

*Simpson*  
*Jackson Davis*  
 county well located

3-22 1974  
 date well completed

GRINER - GINN  
 firm name

LANDOWNER:	description of formations encountered	from	to
<i>Hubert Cliburn</i>			
<i>Re. 2. New Hebron, Miss</i> (mailing address)	<i>clay</i>	<i>1</i>	<i>41</i>
	<i>clay &amp; gravel</i>	<i>41</i>	<i>93</i>
	<i>clay &amp; chalk</i>	<i>93</i>	<i>140</i>
	<i>sand</i>	<i>140</i>	<i>183</i>
<b>WELL LOCATION:</b> sec <i>5</i> T <i>9</i> S R <i>20</i> E <i>10</i> miles <i>NW</i> of <i>New Hebron</i> (distance) (direction) (nearest town)			
<b>WELL PURPOSE:</b> <i>Home</i> (home, irrigation, municipal, industrial)			
<b>WELL COMPLETION DATA:</b>			
(1) diameter (inches)	<i>2"</i>		
(2) total depth (feet)	<i>183</i>		
(3) static water level (feet)	<i>150</i> below top of ground.		
(4) casing <i>plastic</i>	<i>173</i>		
	(material) (depth)		
	<i>2"</i> if telescope see back.		
	(size)		
(5) screen <i>10'</i>	<i>173</i>		
	(length) (depth to top)		
	<i>2"</i> <i>plastic</i>		
	(size) (material)		
(6) pump <i>2</i>	<i>8</i>		
	(HP) (yield gpm)		
	<i>elec.</i>		
	(type power)		
(7) electric log <i>No</i>			
	(yes or no)		
	<i>NO</i>		
	(organization running log)		
(8) how well bottom plugged	<i>B.W. Valve</i>		
<b>DRILLERS REMARKS:</b>			


CODED

1974  
 APR 23 1974

MISSISSIPPI BOARD OF WATER COMMISSIONERS

If well telescopes please sketch and show depths.

GROUND LEVEL

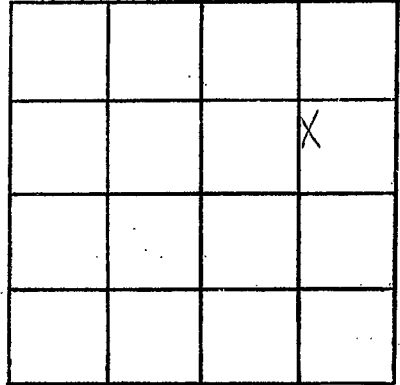

SECTION 5

Please indicate well location X.

ADDITIONAL INFORMATION

If more than one screen,  
show locations of each on sketch.