

SIMPSON
 N 14
 4-18-74

MISSISSIPPI
 BOARD OF WATER COMMISSIONERS
 416 North State Street
 Jackson, Mississippi 39201

CODED

WATER WELL DRILLERS LOG

Simpson
~~Jackson~~ *Davis*
 Locality well located

4-18 1974
 date well completed

GRINER - GINN
 firm name

LANDOWNER:
 Rev. Curtis Cochran
 Rt. 1, New Hebron,
 (mailing address) Miss.

description of formations encountered	from	to
Top Soil	0	1
Clay	1	39
Clay & Chalk	39	81
Sand	81	103

WELL LOCATION:
 sec 27 T 10 S R 20 E
 3 miles W of Shennes
 (distance) (direction) (nearest town)

WELL PURPOSE: Home
 (home, irrigation, municipal, industrial)

WELL COMPLETION DATA:

(1) diameter (inches) 2"

(2) total depth (feet) 103'

(3) static water level (feet) 75' below top of ground.

(4) casing plastic, 93' (material) (depth)
 2" (size) if telescope see back.

(5) screen 10' (length), 103' (depth to top)
 2" (size), plastic (material)

(6) pump 1 (HP), 6 (yield gpm)
 elec (type power)

(7) electric log No (yes or no)
 No (organization running log)

(8) how well bottom plugged
 B.W. valve


CODED

DRILLERS REMARKS:

MISS. RD. OF WATER COMMISSIONERS

If well telescopes please sketch and show depths.

GROUND LEVEL

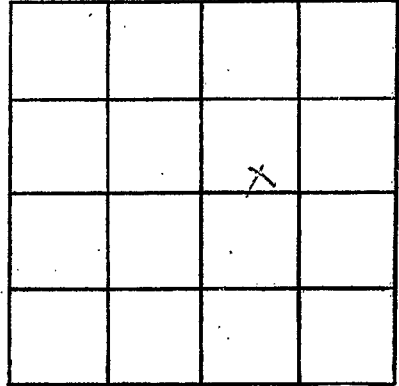

SECTION 27

Please indicate well location X.

ADDITIONAL INFORMATION

If more than one screen,
show locations of each on sketch.