

**SIMPSON**  
**N 15**  
**4-18-74**

MISSISSIPPI  
 BOARD OF WATER COMMISSIONERS  
 416 North State Street  
 Jackson, Mississippi 39201

**CODED**

WATER WELL DRILLERS LOG  
**GRINER - GINN**

*Simpson*  
~~Johnson Davis~~  
 (county well located)

4-18 1974  
 date well completed

firm name

LANDOWNER:  
 John Henry Dixon  
 Rt. 1, New Hebron,  
 (mailing address) Miss

description of formations encountered	from	to
Top Soil	0	1
Clay	1	36
Clay & gravel	36	93
Chalk	93	120
Sand	120	153

WELL LOCATION:  
 sec 26 T 10 N R 20 E  
 3 miles NE of Shivers  
 (distance) (direction) (nearest town)

WELL PURPOSE: Home  
 (home, irrigation, municipal, industrial)

- WELL COMPLETION DATA:
- (1) diameter (inches) 2"
  - (2) total depth (feet) 163
  - (3) static water level (feet) 120 below top of ground.
  - (4) casing plastic, 153,  
 (material) (depth)  
2" if telescope see back.  
 (size)
  - (5) screen 10', 153  
 (length) (depth to top)  
2", plastic  
 (size) (material)
  - (6) pump 1 1/2 ?  
 (HP) (yield gpm)  
elec  
 (type power)
  - (7) electric log NO  
 (yes or no)  
NO  
 (organization running log)
  - (8) how well bottom plugged:  
B.W. Valve


**CODED**

DRILLERS REMARKS:

APR 23 1974  
 MISS. BD. OF WATER COM.

If well telescopes please sketch and show depths.

GROUND LEVEL

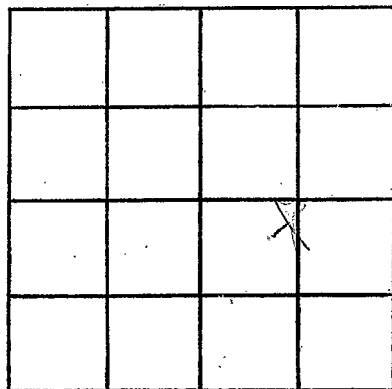

SECTION 26

Please indicate well location X.

ADDITIONAL INFORMATION

If more than one screen,  
show locations of each on sketch.