

SIMPSON
 N 17
 12-23-74

C. P. CLARK
 MISSISSIPPI WATER WELL DRILLING
 BOARD OF WATER COMMISSIONERS ROUTE 2
 416 North State Street LAUREL, MISSISSIPPI 39040
 Jackson, Mississippi 39201

CODED 440

WATER WELL DRILLERS LOG

12/23/1974 C.P. Clark Simpson
 date well completed firm name county well located

LANDOWNER: W. Chester Farmer
S. Magnolia St
Laurel Miss.
 (mailing address)

description of formations encountered	from	to
Red Sandy Clay	0	4
Clay	4	12
Sand & Red Gravel	12	38
Clay	38	41

WELL LOCATION: ~~North~~
 sec. 18 T. ~~1~~ R. ~~3E~~
5 miles SW of Piscola
 (distance) (direction) (nearest town)

WELL PURPOSE: farm
 (home, irrigation, municipal, industrial)

WELL COMPLETION DATA:

- (1) diameter (inches) 2
- (2) total depth (feet) 38
- (3) static water level (feet) 15 below top of ground.
- (4) casing Galv Iron 33
 (material) (depth)
- (size) If telescope see back.
- (5) screen 5 33
 (length) (depth to top)
- 1 1/4 Solid S.S.
 (size) (material)
- (6) pump 1/2 7 1/2
 (HP) (yield gpm)
- 110V S.P.
 (type power)
- (7) electric log NO
 (yes or no)

(organization running log)

(8) how well bottom plugged BWU

DRILLERS REMARKS: Set pit
@ 32 ft


CODED

RECEIVED
 JAN 31 1975

MISS. DD. OF WATER

If well telescopes please sketch and show depths.

GROUND LEVEL

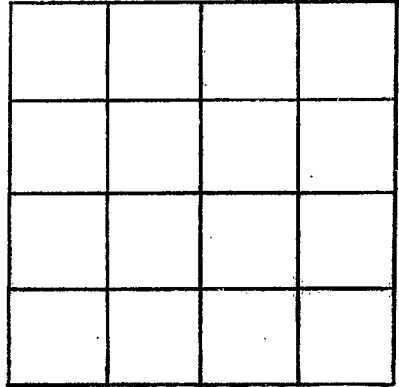

SECTION _____

Please indicate well location X.

ADDITIONAL INFORMATION

If more than one screen, show locations of each on sketch.