

SIMPSON
 N 19
 C-1-79
 E log # 229

MISSISSIPPI
 BOARD OF WATER COMMISSIONERS
 416 North State Street
 Jackson, Mississippi 39201

CODED


WATER WELL DRILLERS LOG

6-21-19 79 date well completed
 Simpson firm name
 Simpson county well located

LANDOWNER:	description of formations encountered	from	to
Gene Lee Dean (mailing address)	Sand	0	160
WELL LOCATION:	CODED		
sec. 34 T 10 N R 3 E (distance) miles (direction) of (nearest town)			
WELL PURPOSE: (home, irrigation, municipal, industrial)			
WELL COMPLETION DATA:			
(1) diameter (inches) 2"			
(2) total depth (feet) 160			
(3) static water level (feet) 100 below top of ground.			
(4) casing PVC, 160 (material) (depth)			
(size) 9 if telescope see back.			
(5) screen 90' 140 (length) (depth to top)			
(size) 2" PVC (material)			
(6) pump 2 (HP) 7 (yield gpm)			
(type power)			
(7) electric log (yes or no)			
(organization running log) MCS			
(8) how well bottom plugged Best			
DRILLERS REMARKS:	10-3-79 [Signature]		

If well telescopes please sketch and show depths.

GROUND LEVEL

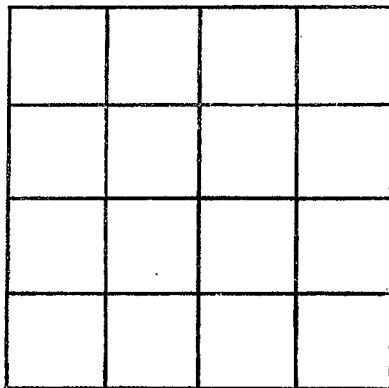

SECTION _____

Please indicate well location X.

ADDITIONAL INFORMATION

If more than one screen,
show locations of each on sketch.