

SIMPSON
 N 20
 10-24-79

MISSISSIPPI
 BOARD OF WATER COMMISSIONERS
 416 North State Street
 Jackson, Mississippi 39201

CODED

WATER WELL DRILLERS LOG

10-24¹⁹ Griner Drilling

SIMPSON
 county well located

date well completed

firm name

county well located

LANDOWNER:

Callons Petroleum
 P.O. Box 1289
 Natchez, Ms 39120
 (mailing address)

description of formations encountered

from to

Clay + sand	0	35
clay, sand, gravel	35	56
clay + sand	56	77
sand + gravel	77	98
sand + gravel	98	119
sand + gravel	119	161
clay, rock, clay	161	183
clay	183	245
clay, sand 8'	245	266
sand, clay, sand	266	287
sand	287	367
sand + clay	367	403

WELL LOCATION:

2640' S + 1200' E
 sec. 21 T. 10 N R. 7 E of
 Hwy 35 - Shivers
 (distance) (direction) (nearest town)

WELL PURPOSE: oil field supply
 (home, irrigation, municipal, industrial)

WELL COMPLETION DATA:

- (1) diameter (inches) 3"
- (2) total depth (feet) 403'
- (3) static water level (feet) 80' ^{below} _{above} top of ground.
- (4) casing steel 36'
 (material) (depth)
3"
 (size) if telescope see back.
- (5) screen 42" 319'
 (length) (depth to top)
3" perforated
 (size) (material)
- (6) pump 75
 (HP) (yield gpm)
AC
 (type power)
- (7) electric log -
 (yes or no)
-
 (organization running log)

(8) how well bottom plugged orange peel

DRILLERS REMARKS:


DEPT. OF NATURAL RESOURCES
 BUREAU OF LAND & WATER RESOURCES

NOV 13 1979

RECEIVED

If well telescopes please sketch and show depths.

GROUND LEVEL

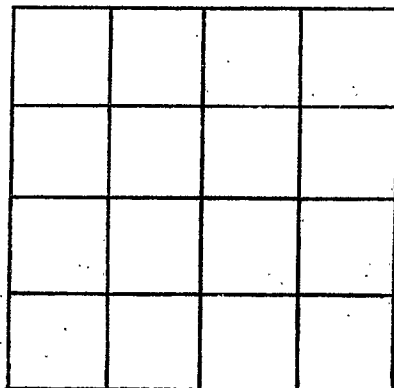

SECTION _____

Please indicate well location X.

ADDITIONAL INFORMATION

If more than one screen,
show locations of each on sketch.