

SIMPSON  
 N21  
 11-29-79  
 Log # 239  
 11-29-79

MISSISSIPPI  
 BOARD OF WATER COMMISSIONERS  
 416 North State Street  
 Jackson, Mississippi 39201

WATER WELL DRILLERS LOG

date well completed

firm name

county well located

1979 Gunn water well Simpson

LANDOWNER:  
 Matt Lee  
 (mailing address)  
 WELL LOCATION:  
 sec. 18 T10 N R20 E W  
 (distance) miles (direction) of (nearest town)

description of formations encountered	from	to
CLAY	0	40
Sand	40	56
CLAY	56	100
Sand	100	140

WELL PURPOSE:  
 (home, irrigation, municipal, industrial)

- WELL COMPLETION DATA:
- (1) diameter (inches) 4"
  - (2) total depth (feet) 140
  - (3) static water level (feet) 60 below top of ground
  - (4) casing (material) PVC (depth) 120
  - (5) screen (size) 4 (length) 20 (depth to top) 120
  - (6) pump (size) 4 (material) PVC (HP) 1 (yield gpm) 15

(type power)  
 (7) electric log (yes or no) MGS (organization running log)  
 (8) how well bottom plugged Best

DEPT. OF NATURAL RESOURCES  
 BUREAU OF LAND & WATER RESOURCES


MAY 28 1980

RECEIVED

DRILLERS REMARKS:

If well telescopes please sketch and show depths.

GROUND LEVEL

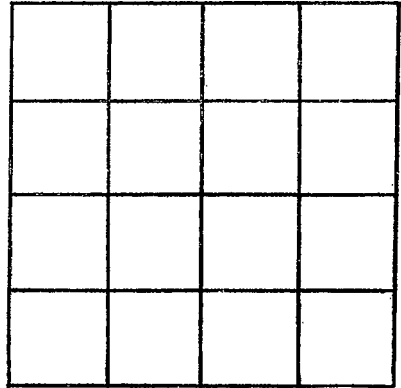

SECTION \_\_\_\_\_

Please indicate well location X.

ADDITIONAL INFORMATION

If more than one screen, show locations of each on sketch.