

MISSISSIPPI  
 BOARD OF WATER COMMISSIONERS  
 416 North State Street  
 Jackson, Mississippi 39201  
 MS-GW-#23  
 WATER WELL DRILLERS LOG

CODED

Simpson  
 N2#3  
 5-26-81  
 Elsg #261

5-26-81 19 T.M. PARKS DRLG. CO. SIMPSON  
 date well completed firm name county well located

LANDOWNER: SHIVERS  
 WATER ASSOCIATION, INC.  
 SIMPSON COUNTY, MS.  
 (mailing address)  
 WELL LOCATION:  
 sec. 22 T 10 N R 20 E  
 S W  
 1 1/2 miles NW of SHIVERS  
 (distance) (direction) (nearest town)

description of formations encountered	from	to
RED SAND/GRAVEL	0	88
PINK CLAY/SAND	88	95
SAND	95	130
SAND/GRAVEL	130	190
clay w/sticks shale	190	395
SAND	395	415
shale w/ some clay	415	500
clay and shale	500	540
mostly shale/some clay	540	600
clay & shale	600	760
shale w/fine sand	760	780
sand w/some shale	780	810
shale w/small sand	810	835
clay w/ some shale	835	916

WELL PURPOSE: CITY  
 (home, irrigation, municipal, industrial)


WELL COMPLETION DATA:  
 (1) diameter (inches) 12 3/4"  
 (2) total depth (feet) 185'  
 (3) static water level (feet) 110 below  
 top of ground.  
 (4) casing US steel 135'  
 (material) (depth)  
 123/4  
 (size) if telescope see back.  
 (5) screen 40' 140'  
 (length) (depth to top)  
 8" stainless steel  
 (size) (material)  
 (6) pump 30 214  
 (HP) (yield gpm)  
 3 0  
 (type power)  
 (7) electric log YES  
 (yes or no)  
 MGS  
 (organization running log)  
 (8) how well bottom plugged BPV



DRILLERS REMARKS:

If well telescopes please sketch and show depths.

GROUND LEVEL

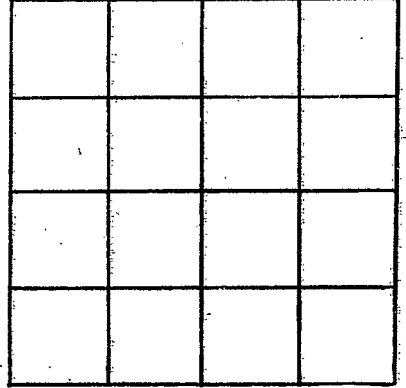

SECTION \_\_\_\_\_

Please indicate well location X.

ADDITIONAL INFORMATION

If more than one screen, show locations of each on sketch.