

Simpson
N 25
6/4/86

MISSISSIPPI
 BOARD OF WATER COMMISSIONERS
 416 North State Street
 Jackson, Mississippi 39201


CODED

WATER WELL DRILLERS LOG

6-4 1986 66 Guinn well ser Simpson
 date well completed firm name county well located

LANDOWNER:	description of formations encountered	from	to
<u>W. M. - Lee</u>			
(mailing address)			
WELL LOCATION:			
sec. <u>24</u> T <u>10</u> N R <u>22</u> S W			
(distance) miles _____ of _____ (direction) (nearest town)			
WELL PURPOSE:			
(home, irrigation, municipal , industrial)			
WELL COMPLETION DATA:			
(1) diameter (inches) <u>4"</u>			
(2) total depth (feet) <u>140</u>			
(3) static water level (feet) <u>70</u> below top of ground.			
(4) casing <u>PVC</u> <u>100</u> (material) (depth)			
<u>4"</u> (size) If telescope see back.			
(5) screen <u>40"</u> <u>100</u> (length) (depth to top)			
<u>4"</u> <u>PVC</u> (size) (material)			
(6) pump <u>3</u> <u>50</u> (HP) (yield gpm)			
(type power)			
(7) electric log _____ (yes or no)			
<u>MCS</u> (organization running log)			
(8) how well bottom plugged <u>BWL</u>			
DRILLERS REMARKS:			

CODED

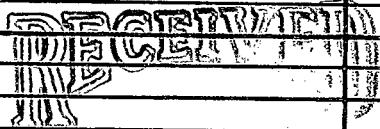


June 2, 1986

Department of Natural Resources
 Bureau of Water Control

If well telescopes please sketch and show depths.

GROUND LEVEL

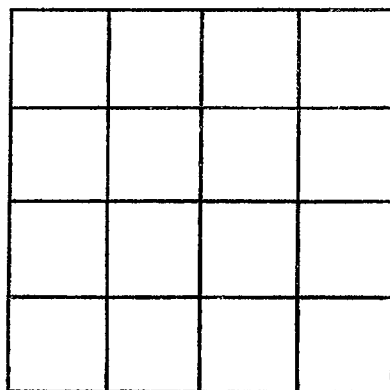

SECTION _____

Please indicate well location X.

ADDITIONAL INFORMATION

If more than one screen,
show locations of each on sketch.