State W	State Well Report		
	Driller's Log	For Office Use Only:	
Mississippi Departmer	nt of Environmental Quality nd Water Resources	Aquifer: N.S.	
	Box 2309	Well #:	
	n, MS 39225	L. S. Elevation:	
	961- 5210 1- 5228 (fax)		
(***.)**		E-log #:	
State Law requires that this report be prepared by the lic Department at the above address within 30 days of comp	pletion of drilling of the well	or borehole.	
Information on Well Owner	Well or Bo	orehole Location	
(Landowner if borehole is not for a water well)	Latitude: 31 . 46 . 49	_" Longitude: 89 . 56 , 45 ."	
Owner Name <u>Dreg Richard</u>	Method of Lat/Long (circle or		
Mailing Address: 495 D.K. Mansfield		GPS, Survey-grade GPS	
Pinolo MS 39149	• •	Twn the Rng 19W	
City State 7 in Code		4	
Telephone No. $(225 - 938 - 9/98)$	City State Zip Code Distance Direction Nearest Town Telephone No. Image: State Image: Stat		
Well / Bore	hole Data		
Date drilling started: $\frac{\sqrt{5}}{2}$ Date drilling completed: $\frac{10-2}{10}$	-09 Hole depth: 175	Hole diameter: 7	
Location of the source of any surface water used for drilling: <u>Creek</u> Method of dosing and volume of Chlorine used in drilling and development: <u>346 Shoek</u>			
Logs run (circle all applicable): No log run Electric Gamma Ray Density Sonic Neutron Other:			
Purpose of borehole (check one): Water Well $\underline{\nu}$ Geotechnical/Geol	ogical Investigation Ground	i Source Heat Pump	
Seismic Survey Other (<i>describe</i> If drilling is not related to water well construction	e)	ock	
Purpose of Well (check one): Home $\underline{\mathcal{V}}$ Industrial Public Supply			
If a flowing well, method of flow regulation: Valve Other (describe)			
Static Water Level:feet above or below (circle one) land surface Date measured:			
Method of Measurement (circle one) steel tape electric tape			
Well depth: <u>17 S</u> Well grouted to a depth of <u>16 feet</u> Type of grout (circle one): Neat Cement Bentonite Mix			
Casing length: 155^{-} feet Casing diameter: <u>4</u> inches Type of casing: <u>$4VC$</u>			
Screen length: <u>ZO</u> feet Screen diameter: <u>4</u> inches Type of screen: <u>PVC</u>			
Screen slot size: <u>.008</u> inches Setting depth: From <u>155</u> feet to <u>175</u> feet			
Type of completion (circle all applicable): Gravel packed Underreamed Telescoped Open hole Natural Development			
Other (describe):			
Top of lap pipe or reduction in casing:feet. If telescoped or more than one screen, describe on next page			
Form: OLWR-SWR-1A (04/08)			
$\frac{1}{2}$ is a second			
		an a	

به ب

The sketch below only required for water wells


If well telescopes, show depths on sketch. Ground Level_____

Description of formations encountered must be provided for all
wells and boreholes, unless specifically exempted by regulation

NS

Description of Formations Encountered	From (depth)	To (depth)
	Ground Level	2
Chan	2	30
Sal	30	70
Per Dreyd	70	175
		1
	+	
	+	
······		
	_	
		<u> </u>
	ļ	
	1	
	1	1
	1	1
	1	1
	<u> </u>	· L

If more than one screen, show location of each on sketch

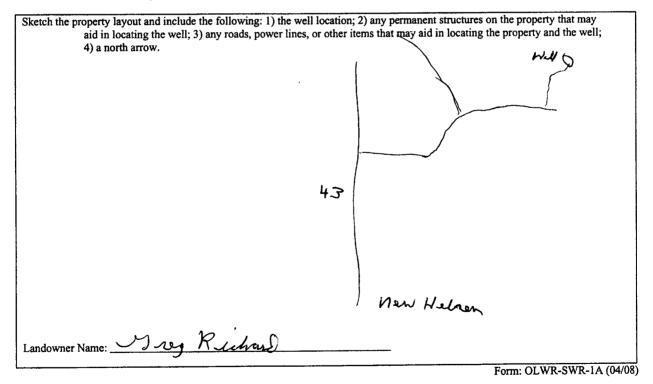

I certify that the well/borehole was drilled, constructed, and completed in accordance with all applicable requirements of the Mississippi Department of Environmental Quality and the Mississippi Department of Health regulations, if applicable, and state

JAMES WELLS 0-586

Wall am

Print Name of Responsible Licensee and License No.

Date

Signature of Licensee

	STATE WELL REPORT	
County: <u></u> Bon Permit #:	Part 2 Pump Installer's Completion Report Mississippi Department of Environmental Quality	For Office Use Only:
Driller: JAMES WELLS Date completed: 10-21-09	P.O. Box 2309 Jackson, MS 39225	
Copy information from block on Part 1	(601)961-5210 (601)961-5228 (fax)	Elevation:
This part of the report must be complete	 ed by a licensed water well contractor or a licensed pump	installer. A copy of Part 1 of the

ан 3 1 °

.

report must be attached and both parts filed with the Department at the above address within 30 days of well completion.		
Well Owner Information	Well Location	
Owner Name: Jreg Richard	Latitude:Longitude:	
Mailing Address: 995 DK Marroy into	Method of Lat/Long (check one): Conventional Survey,	
Pinola MSS	USGS quad, Hand-held GPS, Survey-grade GPS	
39149	<u> 4 sec 6 т. 9 4 к. 19 М</u>	
City State Zip Code	Distance Direction Nearest Town	
Telephone No. 225 - 938 - 9198	Miles SW of Penala	

	Pump Ty Circle on			Power Type Circle one	
Air Lift	Jet	Submersible	Diesel Engine	Gasoline Engine	Natural Gas
Bucket	Piston	Turbine	Electric Motor	Hand	Tractor PTO
Centrifugal	Rotary	Flowing Well	Windmill	Other (specify):	
Other (specify):			Horse Power Ratin	g of Motor:)	
Date Pump Installed:	10-21	-09	Setting Depth:	145-	feet
Rated Pump Capacity:	<u>/</u>	Gallons Per Minute	Number of Stages:		

Pump Test Data	Method of Measuring Water Level Circle one	
Date Well Tested: 10-21-09 Static Water Level (A): 15 Feet Below Land Surface Pumping Water Level (B): 140	Air Line Electric Measuring Line Steel Tape Other (specify):	
Drawdown [(B) – (A)]: / 40 Feet Below Land Surface Test Pumping Rate: / S Gallons Per Minute Duration of Pump Test (minimum 4 hours): 4hours	For flowing well, measured shut in head:feet Well yieldedGPM with a drawdown of feet after hours of pumping	

I HEREBY CERTIFY that the above statements are true to the best of my knowledge.		
JAMES NELLS 0.586	James Walls	
Print Name of Pump Installer and License No. (if applicable)	Signature of Pump Installer	
	Form: OLWR-SWR-1B (04/08)	