

Simpson
 N 2000
 12-10-75

MISSISSIPPI
 BOARD OF WATER COMMISSIONERS
 416 North State Street
 Jackson, Mississippi 39201

WATER WELL DRILLERS LOG

12-10-1975 ¹³¹ Oriver - Gunn Simpson
 date well completed firm name county well located

LANDOWNER:

B.F. Lee

1000 Normandy Dr
 Duxton (mailing address) Miss.

WELL LOCATION:

sec. 26 T. 9 N R. 20 E
1 miles NE of Shivers
 (distance) (direction) (nearest town)

WELL PURPOSE: Hand
 (home, irrigation, municipal, industrial)

WELL COMPLETION DATA:

- (1) diameter (inches) 2"
- (2) total depth (feet) 100
- (3) static water level (feet) 60 below above top of ground.
- (4) casing PVC, 90
 (material) (depth)
- 2"
 (size) if telescope see back.
- (5) screen 10', 90
 (length) (depth to top)
- 2", PVC
 (size) (material)
- (6) pump 1, 8
 (HP) (yield gpm)
- elec
 (type power)
- (7) electric log NO
 (yes or no)

(organization running log)

(8) how well bottom plugged BW Valve

description of formations encountered

from to


<u>Top Soil</u>	<u>0</u>	<u>1</u>
<u>Clay</u>	<u>1</u>	<u>8</u>
<u>Sand</u>	<u>8</u>	<u>19</u>
<u>Gravel</u>	<u>19</u>	<u>47</u>
<u>Clay</u>	<u>49</u>	<u>79</u>
<u>Sand</u>	<u>79</u>	<u>100</u>

DRILLERS REMARKS:

REGISTRATION
 MAR 23 1975

If well telescopes please sketch and show depths.

GROUND LEVEL

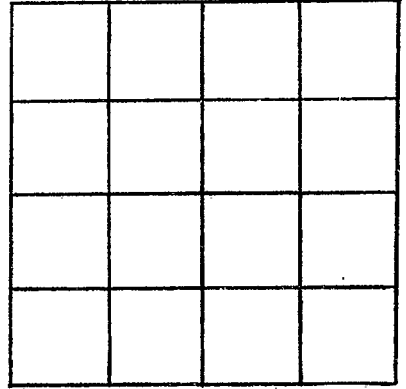

SECTION _____

Please indicate well location X.

ADDITIONAL INFORMATION

If more than one screen,
show locations of each on sketch.