

Simpson
N 2001
2-24-76

MISSISSIPPI
 BOARD OF WATER COMMISSIONERS
 416 North State Street
 Jackson, Mississippi 39201

WATER WELL DRILLERS LOG

2-24 ^{13T} 1976 Oriver-Grow Simpson
 date well completed firm name county well located

LANDOWNER:
Harry Broadhead
Maddephall
 (mailing address)

WELL LOCATION:
 sec. 9 T. 9 N R. 20 W
3 miles NW of Northwood
 (distance) (direction) (nearest town)

WELL PURPOSE: Dom
 (home, irrigation, municipal, industrial)

- WELL COMPLETION DATA:
- (1) diameter (inches) 2"
 - (2) total depth (feet) 185
 - (3) static water level (feet) 160 below above top of ground.
 - (4) casing PVC 175
 (material) (depth)
2"
 (size) if telescope see back.
 - (5) screen 10' 175
 (length) (depth to top)
2" PVC
 (size) (material)
 - (6) pump 2 11
 (HP) (yield gpm)
elec
 (type power)
 - (7) electric log NO
 (yes or no)
 (organization running log)
 - (8) how well bottom plugged B.W. valve


description of formations encountered	from	to
<u>Shale</u>	<u>0</u>	<u>1</u>
<u>Sand</u>	<u>1</u>	<u>12</u>
<u>Clay</u>	<u>12</u>	<u>46</u>
<u>Clay</u>	<u>46</u>	<u>91</u>
<u>Sand & gravel</u>	<u>91</u>	<u>147</u>
<u>Sand</u>	<u>147</u>	<u>185</u>

DRILLERS REMARKS:

REGISTERED
 JAN 29 1976

If well telescopes please
sketch and show depths.

GROUND LEVEL

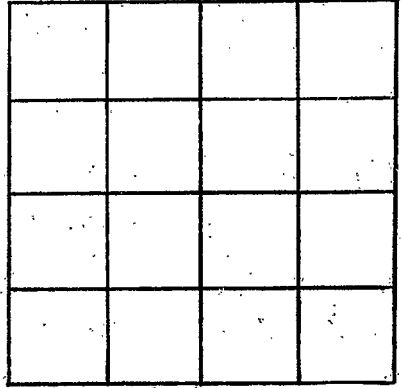

SECTION _____

Please indicate well location X.

ADDITIONAL INFORMATION

If more than one screen,
show locations of each on sketch.