

Simpson
 N 2000
 11-26-76

MISSISSIPPI
 BOARD OF WATER COMMISSIONERS
 416 North State Street
 Jackson, Mississippi 39201

WATER WELL DRILLERS LOG

11-26 1976 Griner-BINN SIMPSON
 date well completed firm name county well located

LANDOWNER:

A. D. Berry

Shivers
 (mailing address) MISS.

description of formations encountered

from to

Top soil	0	1
Clay	1	28
Chalk	28	126
SAND + gravel	126	136
SAND	136	170

WELL LOCATION:

sec. 21 T. 10 N. R. 20 E
4 miles W of Shivers
 (distance) (direction) (nearest town)

WELL PURPOSE:

Home
 (home, irrigation, municipal, industrial)

WELL COMPLETION DATA:

- (1) diameter (inches) 4"
- (2) total depth (feet) 170
- (3) static water level (feet) 90 below above top of ground.
- (4) casing PVC, 150,
 (material) (depth)
4" if telescope see back.
 (size)
- (5) screen 10', 150
 (length) (depth to top)
4", PVC
 (size) (material)
- (6) pump 3/4 (HP) (yield gpm)
elec
 (type power)
- (7) electric log no (yes or no)

(organization running log)

(8) how well bottom plugged:
B.W. Valve

DRILLERS REMARKS:


RECEIVED

MAR 23 1977

MISS. BD. OF WATER COMM.

If well telescopes please sketch and show depths.

GROUND LEVEL

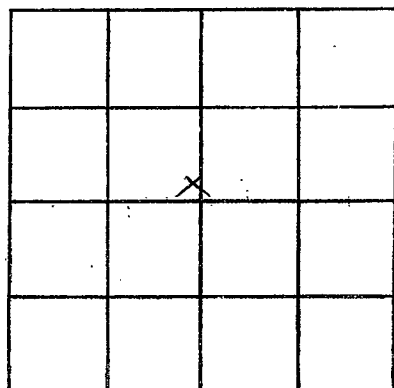

SECTION 21

Please indicate well location X.

ADDITIONAL INFORMATION

If more than one screen,
show locations of each on sketch.