

Simpson
 N 2004
 8/16/77

MISSISSIPPI
 BOARD OF WATER COMMISSIONERS
 416 North State Street
 Jackson, Mississippi 39201

WATER WELL DRILLERS LOG

Aug. 16 19 77 Binn Well Service Simpson
 date well completed firm name county well located


LANDOWNER:	description of formations encountered	from	to
James Bayington Shivers Miss - (mailing address)	Top Soil Clay Chalk Sand	0 1 16 107	1 16 107 165
WELL LOCATION: sec. <u>31</u> T <u>N</u> R. <u>20</u> E <u>2</u> miles <u>E</u> of <u>Shivers</u> (distance) (direction) (nearest town)			
WELL PURPOSE: <u>Home</u> (home, irrigation, municipal, industrial)			
WELL COMPLETION DATA:			
(1) diameter (inches) <u>4"</u>			
(2) total depth (feet) <u>165 ft.</u>			
(3) static water level (feet) <u>100</u> below/above top of ground.			
(4) casing <u>Plastic</u> , <u>155 ft.</u> (material) (depth)			
<u>4"</u> (size) if telescope see back.			
(5) screen <u>10 ft.</u> , <u>155 ft.</u> (length) (depth to top)			
<u>4"</u> , <u>Plastic</u> (size) (material)			
(6) pump <u>1</u> <u>14</u> (HP) (yield gpm)			
<u>Elev</u> (type power)			
(7) electric log <u>no</u> (yes or no)			
(organization running log)			
(8) how well bottom plugged <u>B.W. Valve</u>			
DRILLERS REMARKS:			

RECEIVED
 DEC 16 1977

MISS. BD. OF WATER COMMISSIONERS

If well telescopes please sketch and show depths.

GROUND LEVEL

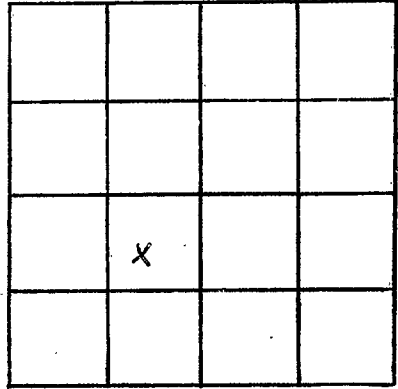

SECTION 35

Please indicate well location X.

ADDITIONAL INFORMATION

If more than one screen,
show locations of each on sketch.