

Simpson
 N 2005
 11/28/77

MISSISSIPPI
 BOARD OF WATER COMMISSIONERS
 416 North State Street
 Jackson, Mississippi 39201

WATER WELL DRILLERS LOG

Nov 28 1977 Roy Westwaterwell Simpson
 date well completed firm name county well located

LANDOWNER: <u>Roy Westwaterwell</u>	description of formations encountered	from	to
<u>Gen Del Shivers Miss</u>			
	clay	0	8
	sandy clay	8	35
	sand	35	130

(mailing address)
 WELL LOCATION:
 sec. 29 T. 10 N. R. 30 E.
1 miles N of Shivers
 (distance) (direction) (nearest town)

WELL PURPOSE: home
 (home, irrigation, municipal, industrial)

- WELL COMPLETION DATA:
- (1) diameter (inches) 2
 - (2) total depth (feet) 130
 - (3) static water level (feet) 90 below above top of ground.
 - (4) casing PVC 125
 (material) (depth)
 (size) If telescope see back.
 - (5) screen 5 125
 (length) (depth to top)
1/4 st steel
 (size) (material)
 - (6) pump 1 1/2 10
 (HP) (yield gpm)
R&A
 (type power)
 - (7) electric log no
 (yes or no)
 - (organization running log)
 - (8) how well bottom plugged wash well


DRILLERS REMARKS:

RECEIVED
 DEC 15 1977

MISS. BD. OF WATER CONTROL

If well telescopes please sketch and show depths.

GROUND LEVEL

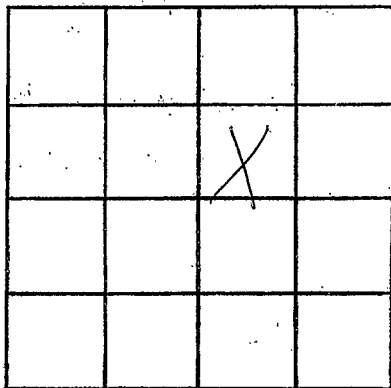

SECTION 27

Please indicate well location X.

ADDITIONAL INFORMATION

If more than one screen, show locations of each on sketch.