

SIMPSON
 N 2008

MISSISSIPPI
 BOARD OF WATER COMMISSIONERS
 416 North State Street
 Jackson, Mississippi 39201

WATER WELL DRILLERS LOG

Simpson Co.

April 5 19 78
 date well completed

TOM GRIFFITH
 PLUMBING & WELL SERVICE, INC
 320 MAYSON AVE
 county well located

LANDOWNER:

Harold Cody

(mailing address)

WELL LOCATION:

sec. 34 T. 10 N. R. 20 W. 37
2 miles W of Shawney
 (distance) (direction) (nearest town)

WELL PURPOSE: Home
 (home, irrigation, municipal, industrial)

WELL COMPLETION DATA:

- (1) diameter (inches) 2"
- (2) total depth (feet) 160
- (3) static water level (feet) 123 below top of ground.
- (4) casing Plastic, 150
 (material) (depth)
N/A if telescope see back.
 (size)
- (5) screen 10, 150
 (length) (depth to top)
2, Plastic
 (size) (material)
- (6) pump 2, 3
 (HP) (yield gpm)
gluc
 (type power)
- (7) electric log no
 (yes or no)
N/A
 (organization running log)
- (8) how well bottom plugged rock hard valve

description of formations encountered	COLUMBIA, MS 39429	
	from	to
<u>top soil</u>	<u>0</u>	<u>1</u>
<u>clay</u>	<u>1</u>	<u>10</u>
<u>glauconitic sand</u>	<u>10</u>	<u>30</u>
<u>plastic</u>	<u>30</u>	<u>60</u>
<u>sand & gravel</u>	<u>60</u>	<u>160</u>

DRILLERS REMARKS:


RECEIVED

MAY 24 1978

MISS. BD. OF WATER COMM.

If well telescopes please sketch and show depths.

GROUND LEVEL

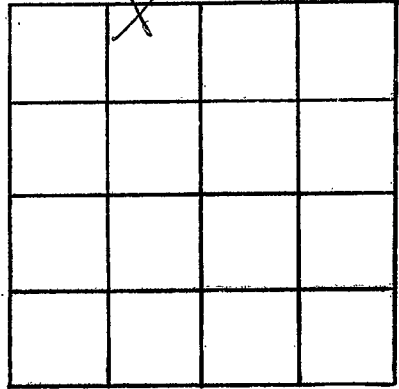

SECTION _____

Please indicate well location X.

ADDITIONAL INFORMATION

If more than one screen,
show locations of each on sketch.