

SIMPSON  
 N 200A

MISSISSIPPI  
 BOARD OF WATER COMMISSIONERS  
 416 North State Street  
 Jackson, Mississippi 39201

WATER WELL DRILLERS LOG  
 TOM GRIFFITH

4-25-78  
 date well completed

1978 PLUMBING & WELL SERVICE, INC.

320 WATSON AVE.  
 COLUMBIA, MS 39429

Simpson  
 county/well located

LANDOWNER:

Mr. Herbert Lee  
 Shively Silver Creek Miss.  
 (mailing address)

description of formations encountered

top soil  
 1' clay  
 clay  
 sand

from to

0 1  
 1 20  
 20 85  
 85 100

WELL LOCATION:

sec. 36 T 100 N S R. 20 E W  
 2 miles E of Shively  
 (distance) (direction) (nearest town)

WELL PURPOSE:

dry pond & house  
 (home, irrigation, municipal, industrial)

WELL COMPLETION DATA:

- (1) diameter (inches) 4"
- (2) total depth (feet) 100 ft.
- (3) static water level (feet) 52 ft. below top of ground.
- (4) casing (material) (depth) 80 ft. plastered  
 (size) 4" if telescope see back.
- (5) screen (length) (depth to top) 20 ft. 80 ft.  
 (size) 4" (material) plastered
- (6) pump (HP) (yield gpm) 3/4 HP  
 (type power) E. Gen.
- (7) electric log (yes or no) no  
 (organization running log) n/a
- (8) how well bottom plugged Back Wash Valve

RECEIVED


MAY 24 1978

DRILLERS REMARKS:

MISS. BD. OF WATER COMMISSIONERS

If well telescopes please sketch and show depths.

GROUND LEVEL

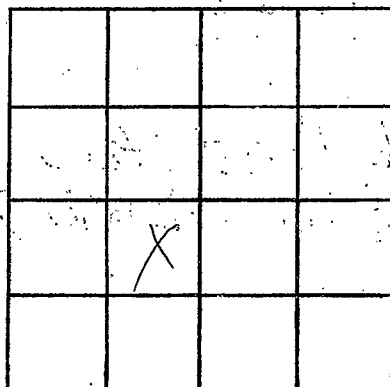

SECTION 3/6

Please indicate well location X.

ADDITIONAL INFORMATION

If more than one screen,  
show locations of each on sketch.