

SIMPSON
 N 2010
 7-24-78

MISSISSIPPI
 BOARD OF WATER COMMISSIONERS
 416 North State Street
 Jackson, Mississippi 39201

WATER WELL DRILLERS LOG

July 24 1978 date well completed
 TOM GRIFFITH
 PLUMBING & WELL SERVICE, INC.
 Simpson county well located

LANDOWNER:
 Frank G. Mahler
 Shivers, Miss -
 (mailing address)

description of formations encountered	from	to
Top Soil	0	3
Gravel	3	30
Sand & Gravel	30	80
Chalk	80	110
Sand	110	150

WELL LOCATION:
 sec. 29 T~~12~~N R. 7~~5~~E
 7 miles W of Shivers
 (distance) (direction) (nearest town)


WELL PURPOSE: Home
 (home, irrigation, municipal, industrial)

- WELL COMPLETION DATA:
- (1) diameter (inches) 4"
 - (2) total depth (feet) 150 ft
 - (3) static water level (feet) 100 ft below top of ground.
 - (4) casing Plastic, 140 ft (material) (depth)
 4" (size) if telescope see back.
 - (5) screen 10 ft 140 ft (length) (depth to top)
 4" plastic (size) (material)
 - (6) pump 1/2 hp 250 gpm (HP) (yield gpm)
 Electric (type power)
 - (7) electric log No (yes or no)

(organization running log)

(8) how well bottom plugged
 Back Wash Valve

DRILLERS REMARKS:

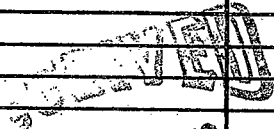


SEP 8 1978

MISS. BB. OF WATER COMM.

If well telescopes please sketch and show depths.

GROUND LEVEL

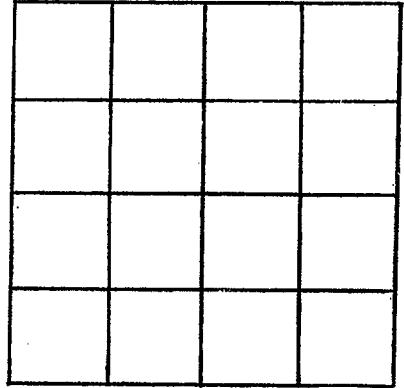

SECTION _____

Please indicate well location X.

ADDITIONAL INFORMATION

If more than one screen, show locations of each on sketch.