

SIMPSON
 N 2011
 10326-78

MISSISSIPPI
 BOARD OF WATER COMMISSIONERS
 416 North State Street
 Jackson, Mississippi 39201

WATER WELL DRILLERS LOG
 TOM GRIFFITH
 PLUMBING & WELL SERVICE, INC.

10/26/78
 date well completed

320 MAPLESON AVE.
 COLUMBIA, MS 39420

Simpson
 county well located

LANDOWNER:

Sprights Building & Supply Co. (mailing address) Prentiss

WELL LOCATION:

sec. 3 T. 9 N. R. 20 E. S. 1
7 miles south of Meridian
 (distance) (direction) (nearest town)

WELL PURPOSE:

Home
 (home, irrigation, municipal, industrial)

WELL COMPLETION DATA:

- (1) diameter (inches) 2"
- (2) total depth (feet) 185 ft.
- (3) static water level (feet) 140 ft. below top of ground.
- (4) casing plastic, 165 ft.
 (material) (depth)
2"
 (size) If telescope see back.
- (5) screen 20 ft., 165 ft.
 (length) (depth to top)
2", plastic
 (size) (material)
- (6) pump 1 hp, 8
 (HP) (yield gpm)
Electric
 (type power)
- (7) electric log no
 (yes or no)

(organization running log)

(8) how well bottom plugged
Back Wash Valve

DRILLERS REMARKS:

description of formations encountered

description of formations encountered	from	to
<i>Topsoil</i>	<i>0</i>	<i>1</i>
<i>Clay</i>	<i>1</i>	<i>6</i>
<i>Sand & Gravel</i>	<i>6</i>	<i>29</i>
<i>Gravel</i>	<i>29</i>	<i>38</i>
<i>Sand</i>	<i>38</i>	<i>46</i>
<i>Chalk</i>	<i>46</i>	<i>81</i>
<i>Sand</i>	<i>81</i>	<i>185</i>


RECEIVED
 50

DEC 13 1978

MISS. BD. OF WATER COMM

If well telescopes please sketch and show depths.

GROUND LEVEL

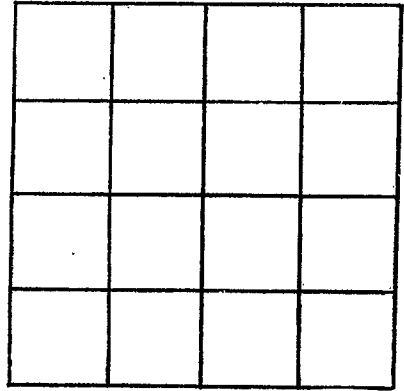

SECTION _____

Please indicate well location X.

ADDITIONAL INFORMATION

If more than one screen,
show locations of each on sketch.