

SIMPSON
 N 2012
 10-25-78

MISSISSIPPI
 BOARD OF WATER COMMISSIONERS
 416 North State Street
 Jackson, Mississippi 39201

WATER WELL DRILLERS LOG

TOM GRIFFITH

PLUMBING & WELL SERVICE, INC.

Simpson
 county well located

10-25-78
 date well completed

firm name

LANDOWNER:
Billy Sherman
Mendenhall Miss.
 (mailing address)

description of formations encountered	from	to
<i>Top Soil</i>	<i>0</i>	<i>2</i>
<i>Clay</i>	<i>2</i>	<i>8</i>
<i>Shale</i>	<i>8</i>	<i>19</i>
<i>Sand</i>	<i>19</i>	<i>31</i>
<i>Chalk</i>	<i>31</i>	<i>90</i>
<i>Sand</i>	<i>90</i>	<i>140</i>
<i>Gravel</i>	<i>140</i>	<i>161</i>
<i>Sand</i>	<i>161</i>	<i>170</i>

WELL LOCATION:
 sec. *34* T *10* N R. *20* E
 S W
1 miles *W* of *Shivers*
 (distance) (direction) (nearest town)

WELL PURPOSE: *Home*
 (home, irrigation, municipal, industrial)

- WELL COMPLETION DATA:
- (1) diameter (inches) *2"*
 - (2) total depth (feet) *180 ft*
 - (3) static water level (feet) *140 ft* Below top of ground.
 - (4) casing *plastic*, *100 ft*
 (material) (depth)
2 (size) If telescope see back.
 - (5) screen *20 ft*, *160 ft*
 (length) (depth to top)
2" (size) *plastic* (material)
 - (6) pump *1 1/2*, *9*
 (HP) (yield gpm)
Electric (type power)
 - (7) electric log *no*
 (yes or no)
- (organization running log)
- (8) how well bottom plugged *B.W. Valve*


DRILLERS REMARKS:

RECEIVED

DEC 13 1978

If well telescopes please
sketch and show depths.

GROUND LEVEL

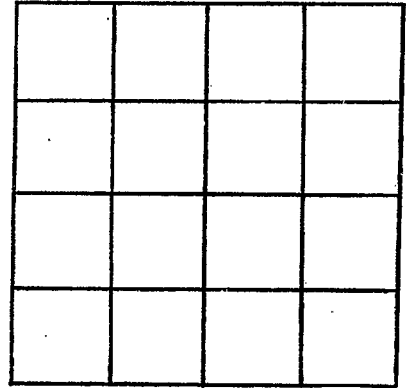

SECTION _____

Please indicate well location X.

ADDITIONAL INFORMATION

If more than one screen,
show locations of each on sketch.