

SIMPSON
 N 2013
 7-29-78

MISSISSIPPI
 BOARD OF WATER COMMISSIONERS
 416 North State Street
 Jackson, Mississippi 39201

WATER WELL DRILLERS LOG

July 29 1978 TOM GRIFFITH
 date well completed PLUMBING & WELL SERVICE, INC. county well located Simpson

LANDOWNER:
 Lloyd McIntosh
 (mailing address)

WELL LOCATION:
 sec. 17 T 18 N R 20 E
 S W
 6 miles (distance) of (direction) of (nearest town)

WELL PURPOSE:
 (home, irrigation, municipal, industrial)

- WELL COMPLETION DATA:
- (1) diameter (inches) 2 1/2 flow well
 - (2) total depth (feet) 450 ft
 - (3) static water level (feet) _____ below/above top of ground.
 - (4) casing _____ (material) _____ (depth) _____
 _____ (size) if telescope see back.
 - (5) screen _____ (length) _____ (depth to top) _____
 _____ (size) _____ (material)
 - (6) pump _____ (HP) _____ (yield gpm) _____
 _____ (type power)
 - (7) electric log _____ (yes or no) _____
 _____ (organization running log)
 - (8) how well bottom plugged _____


description of formations encountered	from	to
top soil	0	2
clay & log	2	21
shale	21	48
chalk	48	705
rock	705	730
sand	730	748
chalk	748	361
hard & rock	361	440
chalk	440	410
hard	410	450

DRILLERS REMARKS:

RECEIVED
 SEP - 8 1978
 MISS. BD. OF WATER COMMISSIONERS

If well telescopes please sketch and show depths.

GROUND LEVEL

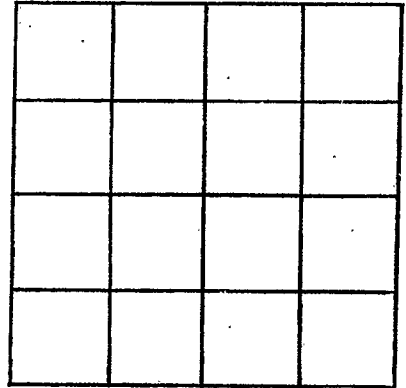

SECTION _____

Please indicate well location X.

ADDITIONAL INFORMATION

If more than one screen, show locations of each on sketch.