

Simpson
N 2016
4-9-79

MISSISSIPPI
 BOARD OF WATER COMMISSIONERS
 416 North State Street
 Jackson, Mississippi 39201

WATER WELL DRILLERS LOG

TOM GRIFFITH

PLUMBING & WELL SERVICE, INC.

320 MAYSON AVE.
 COLUMBIA, MS 39429

Simpson
 county well located

April 9 1979
 date well completed

LANDOWNER:

Wesley Davis
Rt. 7 - Pinola, Miss.
 (mailing address)

description of fomations encountered

from to

<u>Top Soil</u>	<u>0</u>	<u>2</u>
<u>Clay</u>	<u>2</u>	<u>21</u>
<u>Sand</u>	<u>21</u>	<u>42</u>
<u>Gravel</u>	<u>42</u>	<u>61</u>
<u>Cherty</u>	<u>61</u>	<u>102</u>
<u>Hard</u>	<u>102</u>	<u>185</u>

WELL LOCATION:

sec. 27 T 10 N R. 20 E
5 miles S of Pinola
 (distance) (direction) (nearest town)

WELL PURPOSE:

Water
 (home, irrigation, municipal, industrial)

WELL COMPLETION DATA:

- (1) diameter (inches) 4"
- (2) total depth (feet) 185 ft.
- (3) static water level (feet) 140 ft. below top of ground.
- (4) casing plastic, 165 ft.
 (material) (depth)
4" if telescope see back.
 (size)
- (5) screen 20 ft., 165 ft.
 (length) (depth to top)
4" plastic
 (size) (material)
- (6) pump 1/2 hp, 12 gals
 (HP) (yield gpm)
Electric
 (type power)
- (7) electric log no
 (yes or no)

(organization running log)

(8) how well bottom plugged
Backwash Valve

DRILLERS REMARKS:


Miss. Board of Water Comm.

JUL 9 1979

RECEIVED

If well telescopes please sketch and show depths.

GROUND LEVEL

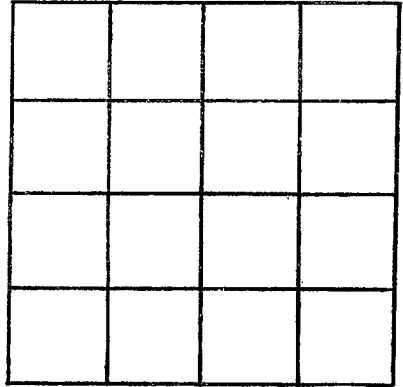

SECTION 22

Please indicate well location X.

ADDITIONAL INFORMATION

If more than one screen,
show locations of each on sketch.