

Simpson
N 205
Mar. 24, 1979
March 24 1979
 date well completed

MISSISSIPPI
 BOARD OF WATER COMMISSIONERS
 416 North State Street
 Jackson, Mississippi 39201

WATER WELL DRILLERS LOG
 TOM GRIFFITH
 PLUMBING & WELL SERVICE, INC.
 firm name

Simpson
 county well located

LANDOWNER:
Mr. Jim Weathersburg
Dinkola, Miss.
 (mailing address)

WELL LOCATION:
 sec. 24 T. 10 N. R. 70 E.
4 miles S of Pinck
 (distance) (direction) (nearest town)

WELL PURPOSE:
Plumbing
 (home, irrigation, municipal, industrial)

WELL COMPLETION DATA:
 (1) diameter (inches) 4"
 (2) total depth (feet) 185 ft
 (3) static water level (feet) 140 ft below top of ground.
 (4) casing Plastic 165 ft
 (material) (depth)
4"
 (size) If telescope see back.
 (5) screen 20 ft 165 ft
 (length) (depth to top)
4" (size) plastic (material)
 (6) pump 3/4 12 gals
 (HP) (yield gpm)
Electric
 (type power)
 (7) electric log no
 (yes or no)
 (organization running log)
 (8) how well bottom plugged
Good Trash Valve


description of formations encountered	from	to
<u>Top soil</u>	<u>0</u>	<u>2</u>
<u>clay</u>	<u>2</u>	<u>8</u>
<u>loam</u>	<u>8</u>	<u>17</u>
<u>gravel</u>	<u>18</u>	<u>40</u>
<u>clay</u>	<u>40</u>	<u>60</u>
<u>hard gravel</u>	<u>60</u>	<u>99</u>
<u>clay</u>	<u>99</u>	<u>160</u>
<u>sand</u>	<u>160</u>	<u>185</u>

Miss. Board of Water Comm.
 JUN 5 1979
 RECEIVED

DRILLERS REMARKS:

If well telescopes please sketch and show depths.

GROUND LEVEL

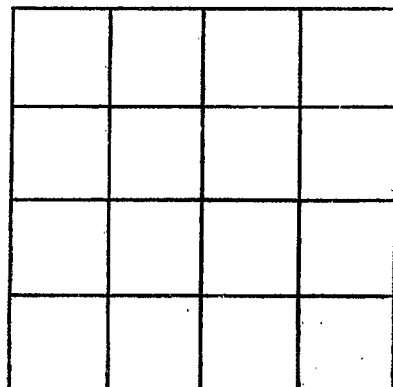

SECTION _____

Please indicate well location X.

ADDITIONAL INFORMATION

If more than one screen, show locations of each on sketch.