

Simpson
 N 2018
 4-5-79

MISSISSIPPI
 BOARD OF WATER COMMISSIONERS
 416 North State Street
 Jackson, Mississippi 39201

WATER WELL DRILLERS LOG

TOM GRIFFITH

PLUMBING & WELL SERVICE, INC.

320 MAYSON AVE.
 COLUMBIA, MS 39420

April 5 1979
 date well completed

Simpson
 county well located

LANDOWNER:
 Roland Dickson
 Shivers, Mrs.
 (mailing address)

description of formations encountered	from	to
Top Soil	0	1'
clay	1	14
Sand	14	30
Gravel	30	49
Shale	49	57
Hard	57	165

WELL LOCATION:
 sec. 20 T-10 S R-70 E
 3 miles W of Stearns
 (distance) (direction) (nearest town)

WELL PURPOSE: Haul
 (home, irrigation, municipal, industrial)

WELL COMPLETION DATA:

- (1) diameter (inches) 2"
- (2) total depth (feet) 165 ft.
- (3) static water level (feet) 80 ft. below top of ground.
- (4) casing (material) plastic, (depth) 145 ft.
 2" (size) if telescope see back.
- (5) screen 20 ft, 145 ft (length) (depth to top)
 2" (size) plastic (material)
- (6) pump 1 1/2 HP, 10 gals. (HP) (yield gpm)
 Electric (type power)
- (7) electric log no (yes or no)

(organization running log)

(8) how well bottom plugged
 Back Valve

DRILLERS REMARKS:


Miss. Board of Water Comm.

JUL 9 1979

RECEIVED

If well telescopes please sketch and show depths.

GROUND LEVEL

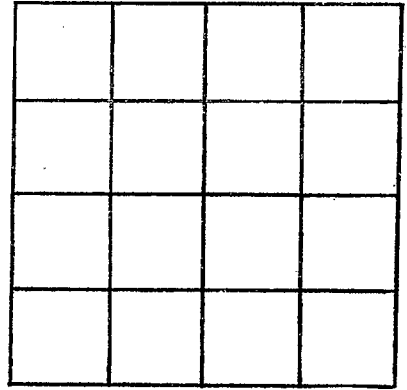

SECTION 20

Please indicate well location X.

ADDITIONAL INFORMATION

If more than one screen, show locations of each on sketch.