

JIMMISON  
TV  
209  
10-24-79

MISSISSIPPI  
 BOARD OF WATER COMMISSIONERS  
 416 North State Street  
 Jackson, Mississippi 39201

WATER WELL DRILLERS LOG

10-24-79 19 JOM GRIFFITH Simpson  
 date well completed firm name county well located

LANDOWNER:  
W. M. Cody  
Shivers, Ms.  
 (mailing address)

description of formations encountered	from	to
	<u>Topsoil</u>	<u>0</u>
<u>Clay</u>	<u>1</u>	<u>15</u>
<u>Sand</u>	<u>15</u>	<u>60</u>
<u>Chalk</u>	<u>60</u>	<u>80</u>
<u>Sand</u>	<u>80</u>	<u>165</u>

WELL LOCATION:  
 sec. 27 T. 10 S. R. 70 E.  
3 miles N of Plain  
 (distance) (direction) (nearest town)

WELL PURPOSE: Temp  
 (home, irrigation, municipal, industrial)

- WELL COMPLETION DATA:
- (1) diameter (inches) 4"
  - (2) total depth (feet) 165'
  - (3) static water level (feet) 130' <sup>below</sup> / <sub>above</sub> top of ground.
  - (4) casing Plastic, 145'  
 (material) (depth)  
4"  
 (size) if telescope see back.
  - (5) screen 20', 145'  
 (length) (depth to top)  
4", Plastic  
 (size) (material)
  - (6) pump 3/4 NO  
 (HP) (yield gpm)
  - ELC  
 (type power)
  - (7) electric log NO  
 (yes or no)  
NONE  
 (organization running log)
  - (8) how well bottom plugged B.W.P.


DEPT. OF NATURAL RESOURCES  
 BUREAU OF LAND & WATER RESOURCES  
 NOV 21 1979

RECEIVED

DRILLERS REMARKS:

...scopes please  
sketch and show depths.

GROUND LEVEL

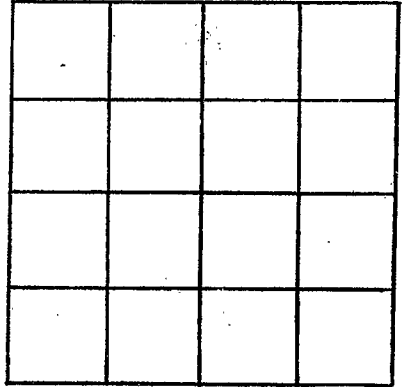

SECTION \_\_\_\_\_

Please indicate well location X.

ADDITIONAL INFORMATION

If more than one screen,  
show locations of each on sketch.