

Simpson
N
2000
10-29-79
10-29 79
 date well completed

MISSISSIPPI
 BOARD OF WATER COMMISSIONERS
 416 North State Street
 Jackson, Mississippi 39201

WATER WELL DRILLERS LOG

TOM GRIFFITH
PLUMBING & WELL SERVICE, INC.
 Well name

Simpson
 county well located

LANDOWNER: <u>Race Smith</u>	description of formations encountered	from	to
<u>New Hebron</u>			
(mailing address)	<u>top sid</u>	<u>0</u>	<u>1</u>
WELL LOCATION:	<u>Sand</u>	<u>1</u>	<u>85</u>
sec. <u>33</u> T. <u>10N</u> S. R. <u>2E</u> W. <u>Shivers</u>	<u>Chalk</u>	<u>85</u>	<u>105</u>
<u>2</u> miles <u>W</u> of <u>Shivers</u>	<u>Rock</u>	<u>105</u>	<u>210</u>
(distance) (direction) (nearest town)	<u>Sand</u>	<u>210</u>	<u>280</u>
WELL PURPOSE: <u>Home</u>			
(home, irrigation, municipal, industrial)			
WELL COMPLETION DATA:			
(1) diameter (inches) <u>4"</u>			
(2) total depth (feet) <u>280'</u>			
(3) static water level (feet) <u>70'</u> below top of ground.			
(4) casing <u>Plastic, 260'</u>			
(material) (depth)			
<u>4"</u> If telescope see back.			
(size)			
(5) screen <u>20'</u> , <u>260'</u>			
(length) (depth to top)			
<u>4"</u> , <u>Plastic</u>			
(size) (material)			
(6) pump <u>None</u> , <u>None</u>			
(HP) (yield gpm)			
<u>No Electric</u>			
(type power)			
(7) electric log <u>NO</u>			
(yes or no)			
<u>None</u>			
(organization running log)			
(8) how well bottom plugged <u>BB, W.V.</u>			
DRILLERS REMARKS:			


DEPT. OF NATURAL RESOURCES
 BUREAU OF LAND & WATER RESOURCES

NOV 21 1979

RECEIVED

If well telescopes please sketch and show depths.

GROUND LEVEL

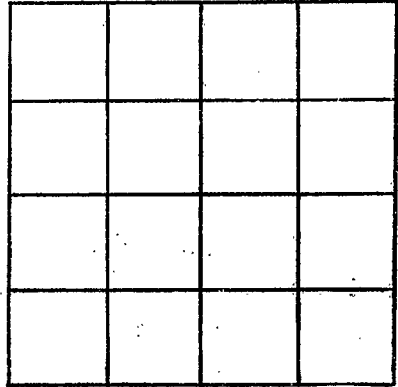

SECTION _____

Please indicate well location X.

ADDITIONAL INFORMATION

If more than one screen, show locations of each on sketch.