

SIMPSON  
N 2021  
4-9-80

MISSISSIPPI  
 BOARD OF WATER COMMISSIONERS  
 416 North State Street  
 Jackson, Mississippi 39201

WATER WELL DRILLERS LOG

April 9 1980 Roy V West Drlg Simpson  
 date well completed firm name county well located

LANDOWNER:	description of formations encountered	from	to
Lionel Westmoland			
General Delivery - Shivers (mailing address)	CLAY-SAND STRS	22	40
	CLAY	40	50
	GRAVEL	50	105

WELL LOCATION:  
 sec. 27 T 10 N R 20 E  
20 miles S of Pinola  
 (distance) (direction) (nearest town)

WELL PURPOSE: HOME  
 (home, irrigation, municipal, industrial)

- WELL COMPLETION DATA:
- (1) diameter (inches) 2
  - (2) total depth (feet) 140'
  - (3) static water level (feet) 105' below above top of ground.
  - (4) casing PVC, 135'  
 (material) (depth)  
 (size) if telescope see back.
  - (5) screen 5', 135'  
 (length) (depth to top)  
1/4, stainless steel  
 (size) (material)
  - (6) pump 1 1/2, 6  
 (HP) (yield gpm)  
REA  
 (type power)
  - (7) electric log N.D.  
 (yes or no)  
 (organization running log)
  - (8) how well bottom plugged WASH VALVE

DRILLERS REMARKS:


DEPT. OF NATURAL RESOURCES  
 BUREAU OF LAND & WATER RESOURCES

APR 16 1980

RECEIVED

If well telescopes please sketch and show depths.

GROUND LEVEL

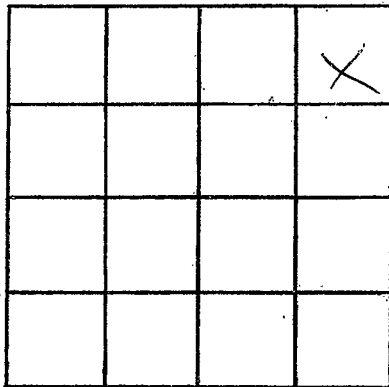

SECTION \_\_\_\_\_

Please indicate well location X.

ADDITIONAL INFORMATION

If more than one screen,  
show locations of each on sketch.