

**MISSISSIPPI
BOARD OF WATER COMMISSIONERS
416 North State Street
Jackson, Mississippi 39201**

WATER WELL DRILLERS LOG

N 2000
6-19-80
June 19 1980
date well completed


C.P. Clark Water
firm name
Simpson
county well located

LANDOWNER:	description of formations encountered	from	to
Rte 2, Box 105 Pinola, Miss (mailing address)	Red & white clay w/ sandy strata Sandy clay w/ clay strata, gravel Gravel & sand w/ other clay Gravel, hard Gravel & sand	0	9 78 78 115 115 129 138
WELL LOCATION: sec. 25 T 10 N R 20 E 1 miles NE of Shivers (distance) (direction) (nearest town)			
WELL PURPOSE: (home, irrigation, municipal, industrial) Home			
WELL COMPLETION DATA:			
(1) diameter (inches) 2			
(2) total depth (feet) 138			
(3) static water level (feet) 84 below top of ground.			
(4) casing galv. 133' (material) (depth)			
(size) If telescope see back.			
(5) screen 5' 133' (length) (depth to top)			
1 1/4" 3SS (size) (material)			
(6) pump 1 3.5 (HP) (yield gpm)			
220V (type power)			
(7) electric log no (yes or no)			
(organization running log)			
(8) how well bottom plugged B.W.V			
DRILLERS REMARKS:			

DEPT. OF NATURAL RESOURCES
BUREAU OF LAND & WATER RESOURCES
JUL - 3 1980
RECEIVED

If well telescopes please sketch and show depths.

GROUND LEVEL

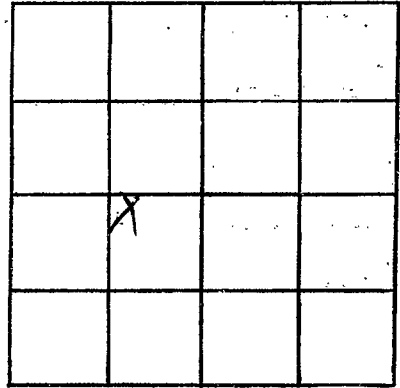

SECTION 25

Please indicate well location X.

ADDITIONAL INFORMATION

If more than one screen, show locations of each on sketch.