

SIMPSON
N 2023
8-4-81

MISSISSIPPI
 BOARD OF WATER COMMISSIONERS
 416 North State Street
 Jackson, Mississippi 39201

WATER WELL DRILLERS LOG

8-4-81 19 Tom Griffiths Well Serv. Simpson
 date well completed firm name county well located

LANDOWNER: <u>Tim Brown</u>	description of formations encountered	from	to
<u>See D.D.</u>			
<u>5 Rivers, Miss</u> (mailing address)	<u>Red Clay</u>	<u>3</u>	<u>32</u>
	<u>Sandy</u>	<u>32</u>	<u>52</u>
	<u>Sand Gravel</u>	<u>52</u>	<u>110</u>

WELL LOCATION:
 sec 26 T 10 N R 20 E
 S W
1 1/2 miles north of Shivers
 (distance) (direction) (nearest town)

WELL PURPOSE: Home
 (home, irrigation, municipal, industrial)


- WELL COMPLETION DATA:
- (1) diameter (inches) 4
 - (2) total depth (feet) 110
 - (3) static water level (feet) 45 below top of ground.
 - (4) casing Steel ~~10~~ 90
 (material) (depth)
 (size) if telescope see back.
 - (5) screen 20 Foot ~~10~~ 90
 (length) (depth to top)
4 Steel
 (size) (material)
 - (6) pump 1 10
 (HP) (yield gpm)
EP
 (type power)
 - (7) electric log no
 (yes or no)
N/A
 (organization running log)
 - (8) how well bottom plugged B.W.U.

DRILLERS REMARKS:

DEPT. OF NATURAL RESOURCES
 BUREAU OF LAND & WATER RESOURCES
 OCT 20 1981
 RECEIVED

If well telescopes please sketch and show depths.

GROUND LEVEL

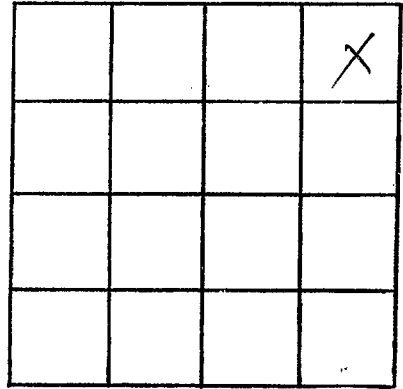

SECTION 26

Please indicate well location X.

ADDITIONAL INFORMATION

If more than one screen,
show locations of each on sketch.