

SIMPSON  
 N 2024  
 1981

MISSISSIPPI  
 BOARD OF WATER COMMISSIONERS  
 416 North State Street  
 Jackson, Mississippi 39201

WATER WELL DRILLERS LOG

Tommy Griffith Well Serv, Simpson  
 firm name county well located

date well completed 19

LANDOWNER: Bill  
 Westminsterland  
 Shrine  
 (mailing address)

| description of formations encountered | from | to  |
|---------------------------------------|------|-----|
| Topsoil                               | 0    | 3   |
| SAAND                                 | 3    | 120 |

WELL LOCATION:  
 sec. 28 T 10 N R 20 E  
 12 miles NW of New Hudson  
 (distance) (direction) (nearest town)

WELL PURPOSE: Home  
 (home, irrigation, municipal, industrial)

- WELL COMPLETION DATA:
- (1) diameter (inches) 2"
  - (2) total depth (feet) 120
  - (3) static water level (feet) 30 below top of ground. <sup>above</sup> <sub>foot</sub>
  - (4) casing Plastic, 120 (material) (depth)  
 (size) If telescope see back.
  - (5) screen Plastic, 120 to 100 (length) (depth to top)  
 2" Plastic (size) (material)
  - (6) pump 1 (HP) 10 (yield gpm)  
 S.P. (type power)
  - (7) electric log No (yes or no)  
 N/A (organization running log)
  - (8) how well bottom plugged B.W.V.

DRILLERS REMARKS:


DEPT. OF NATURAL RESOURCES  
 BUREAU OF LAND & WATER RESOURCES

OCT 20 1987

RECEIVED

If well telescopes please sketch and show depths.

GROUND LEVEL

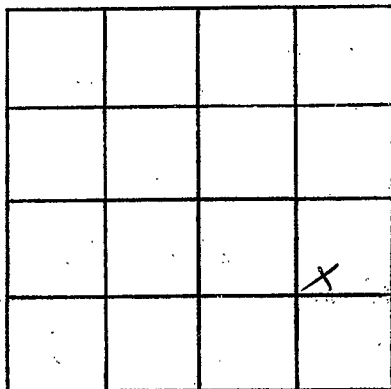

SECTION 26

Please indicate well location X.

ADDITIONAL INFORMATION

A series of horizontal lines for recording additional information.

If more than one screen, show locations of each on sketch.