

MISSISSIPPI DEPARTMENT OF ENVIRONMENTAL QUALITY
Bureau of Land and Water Resources

P. O. Box 10631
Jackson, MS 39289-0631
WATER WELL DRILLERS LOG

COUNTY WELL LOCATED Simpson	
WELL NUMBER N 2030	CODED
DATE WELL COMPLETED 3/21/92	

PERMIT NUMBER 0-402
NAME OF DRILLING FIRM Tom Griffith
Water Well, Inc.

NAME & MAILING ADDRESS OF LANDOWNER Wille Mcintosh		
Re 1, Box 21		
Pinola, ms 39149		
WELL LOCATION: SEC	TOWNSHIP	RANGE
2	10	20
DISTANCE DIRECTION NEAREST TOWN 2 Miles SW of Pinola		
OTHER LANDMARK		
WELL PURPOSE: Home, Irrigation, Municipal, Industrial, Fish Pond, etc. Chicken farm		

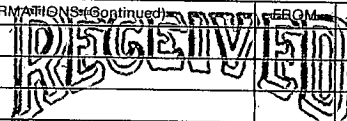
PUMP DATA		
PUMP TYPE (Circle One): <u>Submersible</u> Turbine, Jet, Flowing Well, Other (Describe)		
POWER TYPE (Circle One): <u>Electric</u> Tractor, Diesel, Gasoline, Butane, Other (Describe) H/P 2		
Pump Capacity (GPM) 35	No. of Stages	Setting Depth 200 FT.
PUMP TEST		
Well yielded 35 GPM with a drawdown of _____ ft. after _____ hours of pumping		

WELL DATA		
Well Depth 330	Casing Diameter (In.) 4" -	Casing Length (Ft.) 200' -
Type of Casing PVC	Hole Depth 330	Depth to Static Water Level 5'
TYPE OF COMPLETION: (Circle One or More): Gravel Packed, Underreamed, Telescoped, <u>Natural Development</u> Open Hole, Other (Describe)		
Top of Lap Pipe or Reduction in Casing		
FEET		
IF TELESCOPED OR MORE THAN ONE SCREEN: USE BACK PAGE		

LOG DATA	
TYPE OF LOG RUN (Circle One): <u>No Log Run</u> Electric, Gamma Ray, Density, Sonic, Neutron, Other (Describe)	
Name of Organization Running Log	

SCREEN DATA		
Diameter - Inches 2	Length - Feet 30	Slot Size - Inches .010
Screen Type PVC Slot		Depth to Bottom - Feet 330'

GEOLOGIC DATA (Office Use Only)			
Surface Elev.	Geologic Unit	Unit Thickness	Depth to Top
Subs. SWL	Date	Analysis	Aquifer Test
Driller's Remarks			

DESCRIPTION OF FORMATIONS ENCOUNTERED	FROM	TO	FORMATIONS (Continued)	FROM	TO
clay	1	15	 APR 20 1992 Dept. of Environmental Quality Bureau of Land & Water Resources		
sandy gravel	15	35			
blue clay	35	110			
rock	110	112			
clay	112	170			
rock	170	175			
clay	175	185			
rock	185	215			
clay	215	300			
sand	300	330			
IF MORE SPACE IS NEEDED, USE BACK					

If well telescopes please
sketch and show depths.

GROUND LEVEL

SECTION _____

Please indicate well location X.

ADDITIONAL INFORMATION

If more than one screen,
show location of each on sketch.